IREDELL COUNTY HEALTH DEPARTMENT

STATESVILLE 704-878-5305 (01) MOORESVILLE 704-664-5281

CT

IMPROVEMENT PERMIT / AUTHORIZATION TO CONSTRUCT / OPERATION PERMIT / EXISTING SYSTEM INSPECTION

PERMIT# 122302 PIN# 4716-50-8067 DATE 7/19/04

OWNER OR CONTRACTOR James Foard (Tabatha Nance) PHONE: Business - Home (704) 883-9665

ADDRESS 179 Cedar Ridge Loop Statesville NC 28625

LOCATION Hwy 90 W. @ Little Farm Rd. @ Cedar Ridge Loop (1st entrance), on left past curve @ 179 Cedar Ridge Loop

SUBDIVISION Cedar Ridge BLOCK / SECTION 2 LOT 16 LOT AREA 1.92 Ac SITE CLASS P5 DESIGN FLOW 360 L.T.A.R. .35

Septic Tank: Exist 1000 Gallons; STB 1012 Date 6/15/93
Pump Tank: ____ Gallons; PT ____ Date ____
Pump Make: ____ Model ____ Serial No. ____
Nitrification Field: No Fields 1 Square Feet 339 Linear Feet 115
No Lines 2 Trench Width 36" Max Trench Bottom Depth 30" Gravel Depth 12"

☒ New System ☐ Repair System Type: I (II) III, IV, V, VI
System Description: 6-cavity Conventional
Repair System Description: ~~Trench~~ Pump 25% Reduction
Maintenance Agreement Required: ☐ Yes ☒ No


☐ House/Mod. Home No. Bedrooms 3
☒ Mobile Home No. Bathrooms 2
☐ Business No. Employees ____
☐ Other ____
☐ Slab ☒ Crawl Space ☐ Basement w/plumbing ☐ Basement wo/plumbing

Water Supply: ☐ Individual ☒ Public ☐ Community


Comments:/Conditions: (1) Ex Single wide MH to be removed From property before Cert of Occupancy issued (2) Install 115Ft of septic Line on contour two lines @ 70ft and @ 45Ft. and two (2) drop boxes

Comments:/Conditions:

INITIAL SITE SKETCH

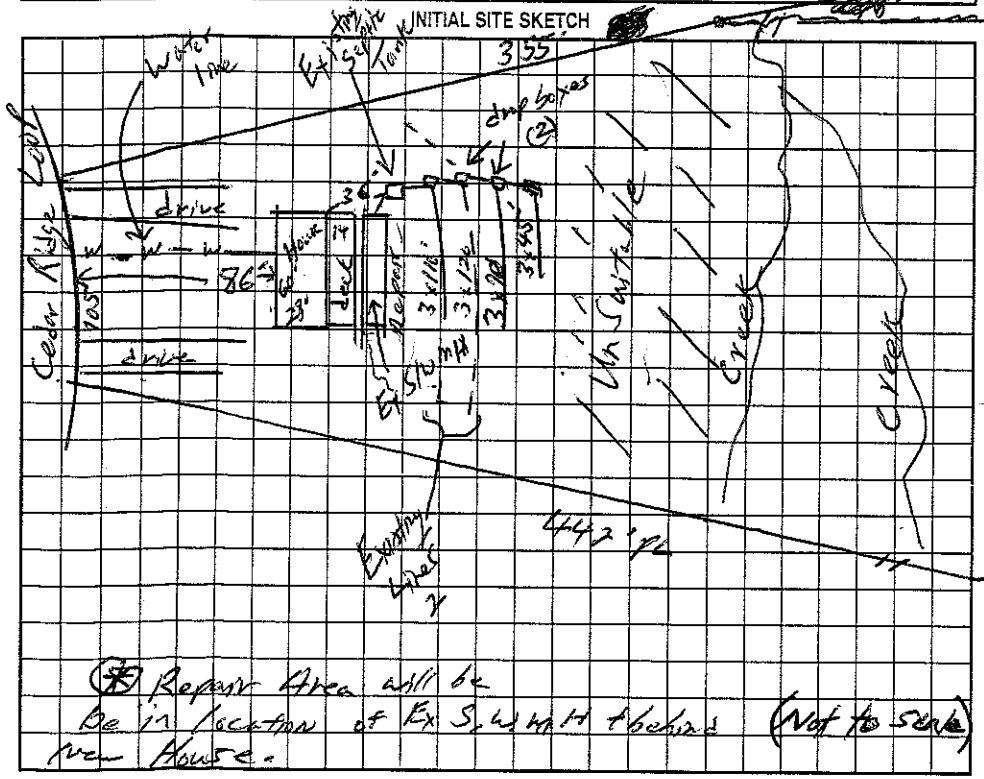

AS BUILT SKETCH

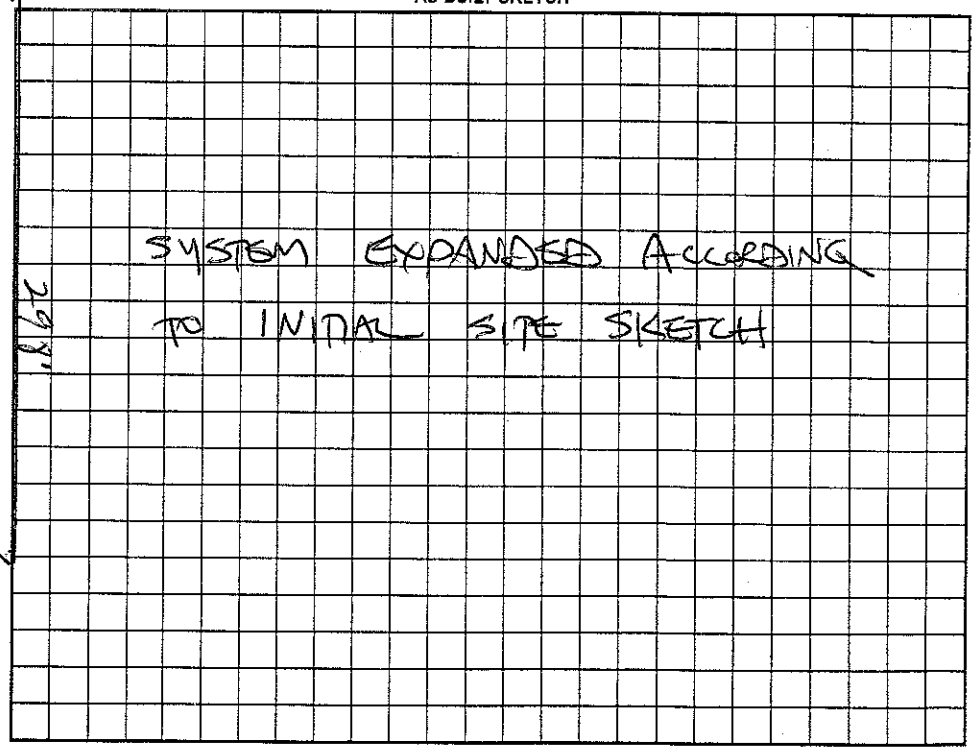

Permit can be suspended or revoked if any false information is supplied toward securing the permit/any unauthorized changes are made to the site/any unauthorized changes are made in the installation of the system. Improvement Permit with plat valid without expiration. Improvement Permit with site plan valid for sixty months. Authorization to Construct is valid for a period equal to that of Improvement Permit – not to exceed sixty months.

Signed: Jonathan Nance date 7-20-04
Improvement Permit by: William O. Johnson date 7/19/04
Authorization to Construct by: William O. Johnson date 7/19/04

Installed by: A-1 BACKHOE
Operation Permit by: STEVE HENDRICK date 9-3-04
Existing System Inspection by: ____ date ____

HEALTH DEPT. COPY: WHITE OWNER COPY (FINAL): YELLOW OWNER COPY (INITIAL): PINK