IREDELL COUNTY HEALTH DEPARTMENT

STATESVILLE 704-878-5305 MOORESVILLE 704-664-5281

IMPROVEMENT PERMIT / CERTIFICATE OF COMPLETION / OPERATION PERMIT / EXISTING SYSTEM INSPECTION

PROPERTY DESCRIPTION NO. 16643 DATE 7/14/93 TAX MAP NO. 9D-12-A-16

OWNER OR CONTRACTOR PATRICIA FOARD PHONE: Business Home 878-0170

ADDRESS RT. 13, LOT 17, CEDAR RIDGE, STATESVILLE, NC 28677

LOCATION NC90W, TR LITTLE FARM RD, TL 1ST CEDAR RIDGE ENT, ON (L) PAST CURVE TO (R)

SUBDIVISION BLOCK / SECTION LOT 16 LOT AREA AMPLE SITE CLASS. PS L.T.A.R. 0.35 GPD/FT²

Water Supply: ☐ Individual ☐ Community ☑ Public

Septic Tank: 1000 Gallons; STB 1012 Date 6/15/93

Pump Tank: Gallons; PT Date

Nitrification Field: No Fields 1 Square Feet 690 Linear Feet 230

No Lines 2 Trench Width 36" Trench Depth 30" Gravel Depth 12"

☑ New System ☐ Repair System Type: I. II (III) IV. V. VI

System Description: CONV. GRAVITY

Repair System Description: CONV. GRAVITY

Maintenance Agreement Required: ☐ Yes ☑ No

☐ House/Mod. Home ☑ Mobile Home ☐ Business ☐ Other

No. Bedrooms 2 No. Bathrooms 1 No. Employees

Garbage Disposal: ☐ Yes ☑ No

Auto. Dishwasher: ~~☑ Yes~~ ☐ No


Auto. Washing Machine: ~~☑ Yes~~ ☐ No

Other

☐ Slab ☑ Crawl Space ☐ Basement w/plumbing ☐ Basement wo/plumbing

Comments (1) KEEP SYSTEM MINIMUM 5' FROM MH, 10' FROM PROPERTY LINE (2) INSTALL LINES ON CONTOUR, NO DEEPER THAN 30", 9' ON CENTER

INITIAL SITE SKETCH

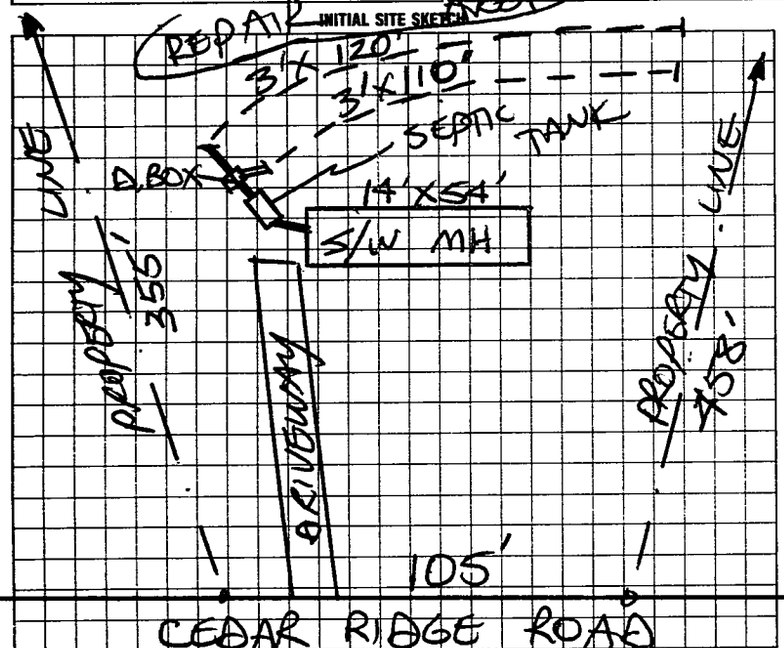

AS BUILT SKETCH

SYSTEM INSTALLED ACCORDING TO INITIAL SITE SKETCH

I understand that this permit can be suspended or revoked if any false information is supplied toward securing the permit/any unauthorized changes are made to the site/any unauthorized changes are made in the installation of the system. Improvement Permit is valid for 60 months from date of issuance.

Signed: X James Foard Jr.

Improvement Permit by: STEVE HEDRICK date 7/14/93

Existing System Inspection by: date

Installed by: FORREST SHUFFORD

Certificate of Completion by: STEVE HEDRICK date 9/9/93

Operation Permit by: date

HEALTH DEPT. COPY: WHITE INSPECTION COPY (FINAL): GREEN OWNER COPY (FINAL): YELLOW INSPECTION COPY (INITIAL): PINK OWNER COPY (INITIAL): GOLD