IREDELL COUNTY HEALTH DEPARTMENT

STATESVILLE 704-878-5305 ✓ MOORESVILLE 704-664-5281

IMPROVEMENT PERMIT / AUTHORIZATION TO CONSTRUCT / OPERATION PERMIT / EXISTING SYSTEM INSPECTION

PERMIT# 106004 PIN# 4716-56-0954.F DATE 5/14/02

OWNER OR CONTRACTOR Fox Marlowe PHONE Business — Home (704) 873-3956

ADDRESS 820 Scotts Creek Road Statesville N.C. 28625

LOCATION Hwy 115 N, ② on Scotts Creek Road, go about 2 3/4 mile to Stonewall Lane on [redacted], dirt road off Scotts Creek

SUBDIVISION — BLOCK / SECTION — LOT — LOT AREA 43 Acres SITE CLASS PS DESIGN FLOW 240 L.T.A.R. .35 gpd/ft²

Septic Tank: 1,000 Gallons: STB 1007 Date 3-27-02
Pump Tank: Gallons: PT Date
Pump Make: Model Serial No
Nitrification Field: No Fields 1 Square Feet 686 Linear Feet 230
No Lines 2@115 Trench Width 36" Max Trench Bottom Depth 36" Gravel Depth 12"

☒ New System ☐ Repair System Type: I (II, III, IV, V, VI)
System Description: Gravity, Conventional
Repair System Description: [redacted] Pump, Conventional
Maintenance Agreement Required: ☐ Yes ☒ No


☐ House/Mod. Home ☒ Mobile Home ☐ Business ☐ Other
No. Bedrooms 2 No. Bathrooms 1 No. Employees
☐ Slab ☒ Crawl Space ☐ Basement w/plumbing ☐ Basement wo/plumbing

Water Supply: ☒ Individual ☐ Public ☐ Community

Comments/Conditions: ① Install lines on Contour ② Maintain proper Setbacks

Comments/Conditions
- S.T. Marker Installed
- Poly Tek Filter Installed

INITIAL SITE SKETCH (Acreage)

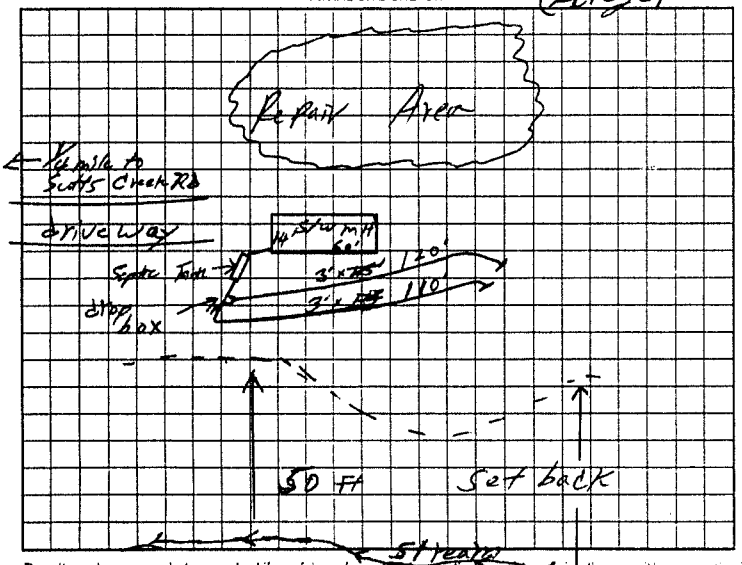

AS BUILT SKETCH

Installed as Shown per Initial Site Sketch

Permit can be suspended or revoked if any false information is supplied toward securing the permit/any unauthorized changes are made to the site/any unauthorized changes are made in the installation of the system. Improvement Permit with plat valid without expiration. Improvement Permit with site plan valid for sixty months. Authorization to Construct is valid for a period equal to that of Improvement Permit - not to exceed sixty months.

Signed: Ray Marlowe date 5-14-02 Installed by: James Hustler

Improvement Permit by: William O. Johnson date 5/14/02 Operation Permit by: William O. Johnson date 5/21/02

Authorization to Construct by: William O. Johnson date 5/14/02 Existing System Inspection by: — date —

HEALTH DEPT COPY: WHITE OWNER COPY (FINAL): YELLOW OWNER COPY (INITIAL): PINK