IREDELL COUNTY HEALTH DEPARTMENT

STATESVILLE 704-878-5305 MOORESVILLE 704-664-5281

IMPROVEMENT PERMIT / CERTIFICATE OF COMPLETION / OPERATION PERMIT / EXISTING SYSTEM INSPECTION

PROPERTY DESCRIPTION NO. 15940 DATE 6/28/93 TAX MAP NO. 9D-12-A-44

OWNER OR CONTRACTOR ACREAGE INVESTMENTS, INC PHONE: Business Home

ADDRESS

LOCATION NC 90 W, TR LITTLE FARM RD, 1ST ENTRANCE CEDAR RIDGE TL, TR 1ST STREET, ON (R)

SUBDIVISION CEDAR RIDGE BLOCK / SECTION LOT 44 LOT AREA AMPLE SITE CLASS. PS L.T.A.R. 0.3560/PT

Water Supply: ☐ Individual ☐ Community ☑ Public

Septic Tank: 1000 Gallons; STB Date

Pump Tank: Gallons; PT Date

Nitrification Field: No Fields 1 Square Feet 1035 Linear Feet 345

No Lines 3 Trench Width 36" Trench Depth Gravel Depth

☐ New System ☐ Repair System Type: I. II. III. IV. V. VI

System Description: CONV. GRAVITY

Repair System Description: CONV. GRAVITY

Maintenance Agreement Required: ☐ Yes ☒ No

☐ House/Mod. Home ☑ Mobile Home ☐ Business ☐ Other

No. Bedrooms 3 No. Bathrooms 2 No. Employees

☐ Slab ☑ Crawl Space ☐ Basement w/plumbing ☐ Basement wo/plumbing

Garbage Disposal: ☐ Yes ☒ No


Auto. Dishwasher: ☐ Yes ☐ No

Auto. Washing Machine: ☑ Yes ☐ No


Other

Comments KEEP MH MINIMUM 5' FROM SYSTEM

INITIAL SITE SKETCH

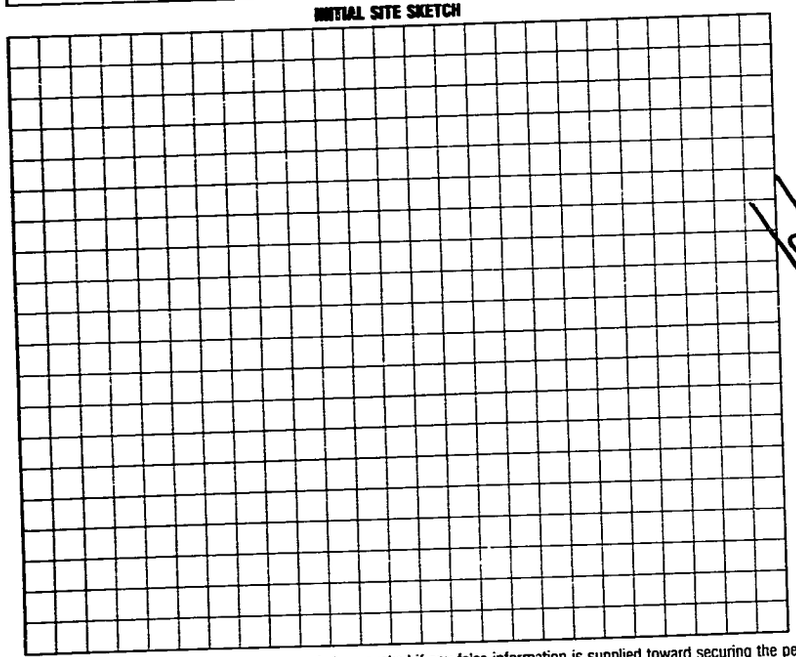

AS BUILT SKETCH

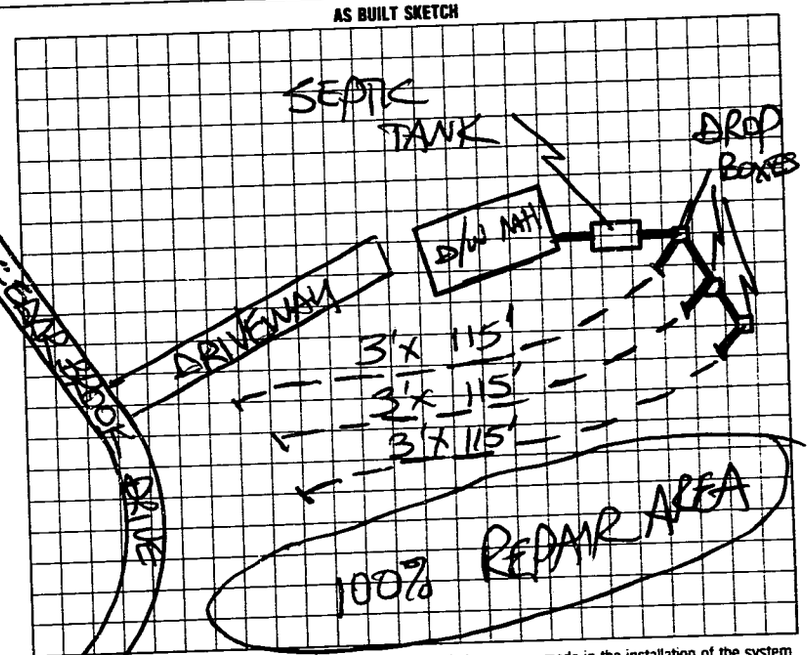

I understand that this permit can be suspended or revoked if any false information is supplied toward securing the permit/any unauthorized changes are made to the site/any unauthorized changes are made in the installation of the system. Improvement Permit is valid for 60 months from date of issuance.

Signed:

Improvement Permit by: STEVE HEDRICK date 3/8/93

Existing System Inspection by: date

Installed by: KEN DELLINGER

Certificate of Completion by: STEVE HEDRICK date 6/28/93

Operation Permit by: date

HEALTH DEPT. COPY: WHITE INSPECTION COPY (FINAL): GREEN OWNER COPY (FINAL): YELLOW INSPECTION COPY (INITIAL): PINK OWNER COPY (INITIAL): GOLD