IREDELL COUNTY HEALTH DEPARTMENT

STATESVILLE 704-878-5305 MOORESVILLE 704-664-5281

IMPROVEMENT PERMIT / AUTHORIZATION TO CONSTRUCT / OPERATION PERMIT / EXISTING SYSTEM INSPECTION

PERMIT# REPAIR PIN# 4716-61-0777 DATE 9-15-03

OWNER OR CONTRACTOR HAROLD McKINNEY PHONE: Business 704-872-3549 Home 704-437-2127

ADDRESS 254 JO MONNI LOOP, STATESVILLE, NC 28625-2368

LOCATION NC 90 W, TR LITTLE FARM ROAD, TL 2ND JO MONNI LOOP, LAST HOUSE ON LEFT BEFORE CURVE

SUBDIVISION JO MONNI ACRES BLOCK / SECTION ____ LOT 21-28 LOT AREA .883 ACRE SITE CLASS. PS DESIGN FLOW 360 L.T.A.R. EXISTING

Septic Tank: 1000 Gallons; STB 1012 Date 4-6-03
Pump Tank: ____ Gallons; PT ____ Date ____
Pump Make: ____ Model ____ Serial No. ____
Nitrification Field: No Fields — Square Feet — Linear Feet —
No Lines — Trench Width — Max Trench Bottom Depth — Gravel Depth —

☐ New System ☑ Repair System Type: I II III IV V VI
System Description: ____
Repair System Description: CONVENTIONAL, GRAVITY
Maintenance Agreement Required: ☐ Yes ☑ No


☑ House/Mod. Home No. Bedrooms 3
☐ Mobile Home No. Bathrooms 2
☐ Business No. Employees ____
☐ Other ____
☐ Slab ☐ Crawl Space ☐ Basement w/plumbing ☐ Basement wo/plumbing

Water Supply: ☑ Individual ☑ Public ☐ Community

Comments:/Conditions: REPLACE EXISTING SEPTIC TANK WITH NEW TANK AT LOCATION SHOWN AS SHALLOW AS POSSIBLE

Comments:/Conditions: USE 32 OUNCES COPPER SULFATE ONCE A YEAR IN SYSTEM TO CONTROL ROOT GROWTH.

INITIAL SITE SKETCH ~SCALE: 1"=50'

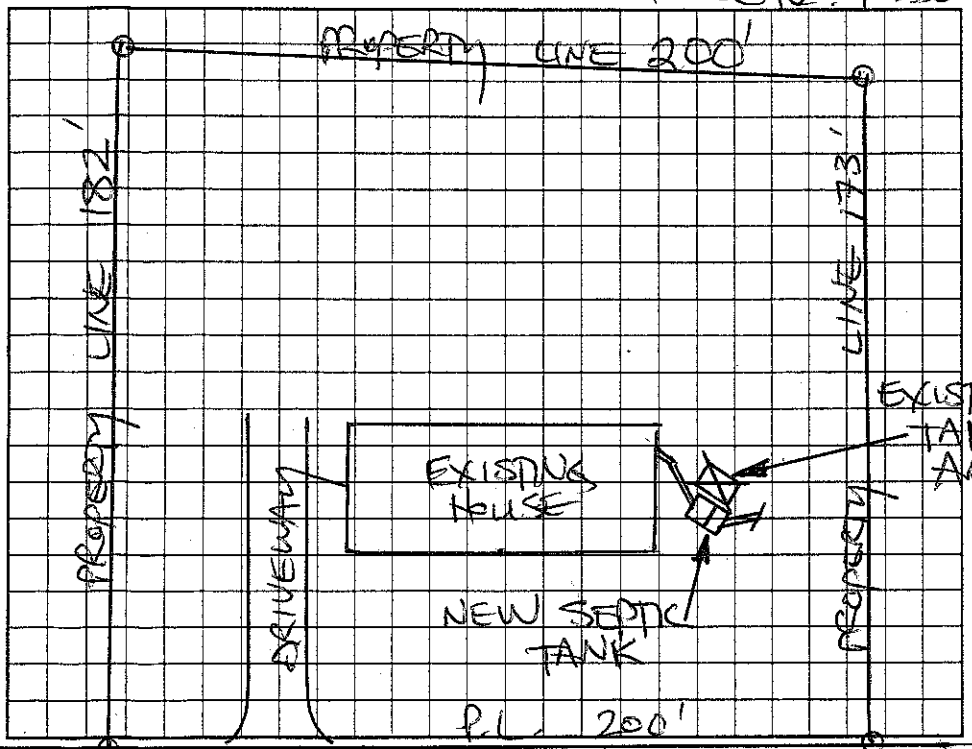

AS BUILT SKETCH

SEPTIC TANK WITH RISERS & MARKER INSTALLED USING 'TUFTITE' FILTER

Permit can be suspended or revoked if any false information is supplied toward securing the permit/any unauthorized changes are made to the site/any unauthorized changes are made in the installation of the system. Improvement Permit with plat valid without expiration. Improvement Permit with site plan valid for sixty months. Authorization to Construct is valid for a period equal to that of Improvement Permit – not to exceed sixty months.

Signed: Harold McKinney date 9-15-03 Installed by: TOMMY FRYE

Improvement Permit by: STEVE HEDRICK date 9-15-03 Operation Permit by: STEVE HEDRICK date 10-17-03

Authorization to Construct by: STEVE HEDRICK date 9-15-03 Existing System Inspection by: ____ date ____

HEALTH DEPT. COPY: WHITE OWNER COPY (FINAL): YELLOW OWNER COPY (INITIAL): PINK