IREDELL COUNTY HEALTH DEPARTMENT

Statesville Phone TR 3-7271 Mooresville Phone NO 3-1271

Permit NO. 206 PERMIT TO INSTALL SEPTIC TANK

Permit Date May 27 1967

Owner George Makaffey Address Statesville

Installed By Roy Funk Address Statesville


Location of Property Sotts Rd. to Perdues Egg Plant
Turn Left, then 2 Rd. to Right then 2 then 1

Tank	Capacity		Length of Lines		Fixtures	
Block ( )	800	( )	150'	( )	No. of Baths	( )
Precast (4)	900	( )	175'	( )	Dishwasher	( )
	1000	(4)	200'	( )	Garbage Grdr.	( )
	1100	( )	225'	(4)	Auto-Washer	( )
	1200	( )	250'	( )	Other	( )
	Other		Other			

NOTIFY HEALTH DEPARTMENT AT LEAST EIGHT HOURS BEFORE TANK IS TO BE INSPECTED.

Final Inspection _____ 19__ Approved ( ) Disapproved ( )

Remarks

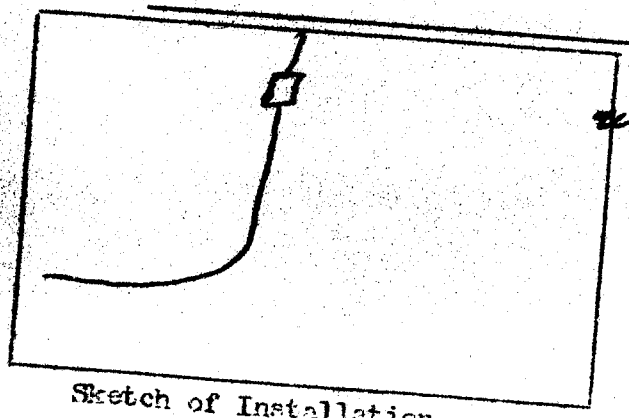

Sketch of Installation

Sanitarian