IREDELL COUNTY HEALTH DEPARTMENT - *ENVIRONMENTAL HEALTH* ☑ STATESVILLE OFFICE 704-878-5305 ☐ MOORESVILLE OFFICE 704-664-5281

IMPROVEMENT PERMIT / AUTHORIZATION TO CONSTRUCT / OPERATION PERMIT / EXISTING SYSTEM INSPECTION

PERMIT # Repair PIN # 4716653346 DATE 8-3-12

OWNER Fay Marlowe APPLICANT: Same PHONE: Home/Cell # 704-873-3956 Business # N/A

SITE ADDRESS 944 Scotts Creek Rd. OWNER / APPLICANT ADDRESS 904 Scotts Creek Rd.

SITE DIRECTIONS Hwy 115 N TL Scotts Creek Rd. On Corner of Scotts Creek & Shanna Ln.

SUBDIVISION N/A BLOCK / SECTION N/A LOT # N/A LOT AREA .78 acres DESIGN FLOW 360 gpd L.T.A.R. 0.3

Septic Tank Existing Gallons: STB ____ Date ____
Pump Tank ____ Gallons: P T ____ Date ____
Pump Make ____ Model ____ Serial # ____
No. Nitrification Fields: 1 No. Lines 4 Linear Feet 296
Trench Width 36" Max. Trench Bottom Depth 36" Gravel Depth N/A


☐ New System ☑ Repair ☐ Expansion System Type I II III IV V VI
System Description: ____
Repair System Description: 25% Reduction
Maintenance Agreement Required ☐ YES ☑ NO
☑ GRAVITY ☐ PRESSURE

☑ Residence No. Bedrooms 3
☐ Business No. Persons ____
☐ Other No. Employees ____
☐ Slab ☑ Crawl Space
☐ Basement w/plumbing ☐ Basement w/o plumbing

Water Supply: ☑ Private ☐ Public ☐ Community

Comments / Conditions: Install 25% Reduction system on Contour w/ Serial distribution; Replace septic tank if needed. Well is 110' away from all components of septic tank system

INITIAL SITE SKETCH

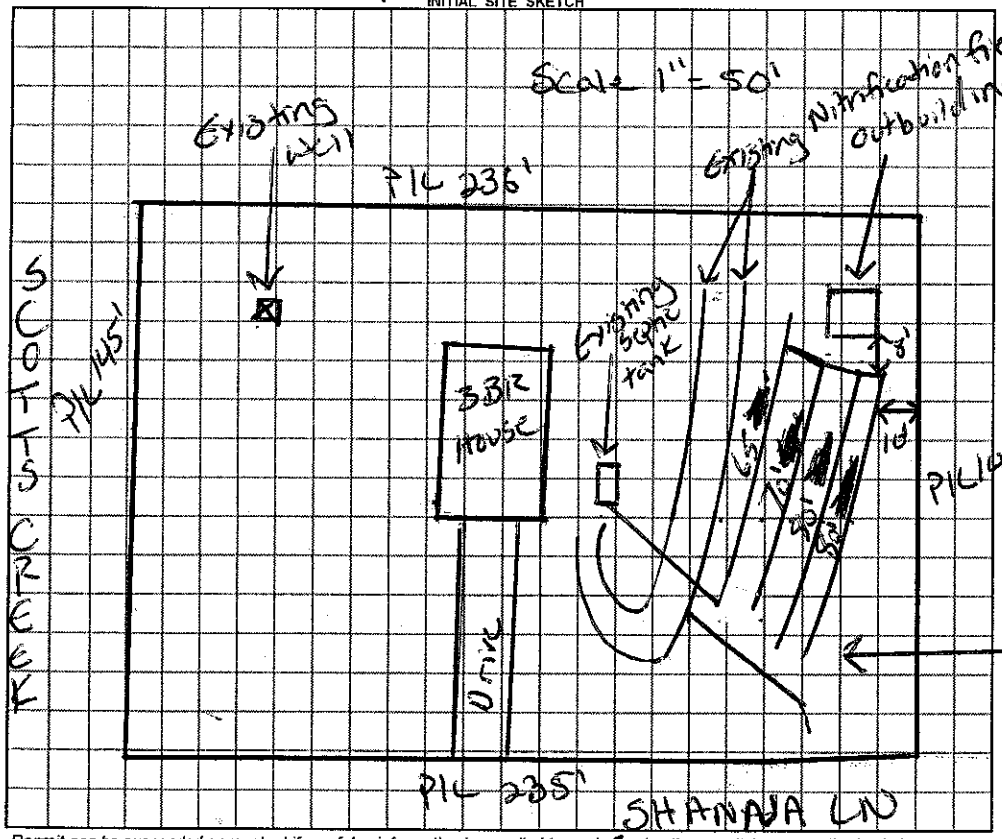

Installed as drawn. ARC 36 Chambers installed. Existing tank used, Tee in tank replaced with PVC Tee

AS BUILT SKETCH

Permit can be suspended or revoked if any false information is supplied toward securing the permit / any unauthorized changes are made to the site / any unauthorized changes are made in the installation of the system.

☐ ***IMPROVEMENT PERMIT*** *with plat valid without expiration.* ☑ ***IMPROVEMENT PERMIT*** *with ~~plat valid without expiration.~~ site plan valid 60 mo.* ☑ ***AUTHORIZATION TO CONSTRUCT*** valid for period equal to IMPROVEMENT PERMIT--not to exceed 60 mo.

Owner / Applicant Signature: Fay Marlowe Date 8-6-12 Installed by: K&M Grading

IMPROVEMENT PERMIT by: Justin Henderson REHS Date 8-3-12 OPERATION PERMIT by: Justin Henderson REHS Date 8-13-12

AUTHORIZATION TO CONSTRUCT by: Justin Henderson REHS Date 8-3-12 Existing System Inspected by: ____ REHS Date ____

YOU SHOULD CONTACT A LOCATOR SERVICE PRIOR TO ANY EXCAVATION

White Copy – Environmental Health YELLOW COPY (Final) Owner / Applicant PINK COPY (Initial) Owner / Applicant