~~1935~~ 63716

IREDELL COUNTY HEALTH DEPARTMENT

STATESVILLE 704-878-5305 MOORESVILLE 704-664-5281

IMPROVEMENT PERMIT / CERTIFICATE OF COMPLETION / OPERATION PERMIT / EXISTING SYSTEM INSPECTION

PROPERTY DESCRIPTION NO. 25226 DATE 10-15-96 TAX MAP NO. 9D-9-A-60 Watershed: ☐ Yes ☒ No

OWNER OR CONTRACTOR FRANKIE L. SHERRILL PHONE: Business Home 872-9732

ADDRESS 151 JO. MONNI LOOP STATESVILLE, NC 28677

LOCATION NC 90 W, TR LITTLE FARM RD, TL 1ST JO MONNI LOOP PS TR AMANDA LANE, 1ST MH ON LEFT

SUBDIVISION HARRY LITTLE BLOCK / SECTION LOT LOT AREA LIMITED SITE CLASS: PS DESIGN FLOW 360 L.T.A.R. 0.35 GPD/FT²

Septic Tank: 1000 Gallons; STB 794 Date 5-15-96

Pump Tank: Gallons; PT Date

Pump Make: Model Serial No.

Nitrification Field: No Fields 1 Square Feet 1035 Linear Feet 345

No Lines FIVE Trench Width 36" Max Trench Bottom Depth 36" Gravel Depth 12"

☒ New System ☐ Repair System Type: I, (II), III, IV, V, VI

System Description: CONVENTIONAL GRAVITY

Repair System Description: CONV. GRAVITY

Maintenance Agreement Required: ☐ Yes ☒ No

☐ House/Mod. Home No. Bedrooms 3

☒ Mobile Home No. Bathrooms 2

☐ Business No. Employees

☐ Other


☐ Slab ☒ Crawl Space ☐ Basement w/plumbing ☐ Basement wo/plumbing

Water Supply: ☒ Individual ☐ Community ☒ Public

Comments:

Comments:

INITIAL SITE SKETCH

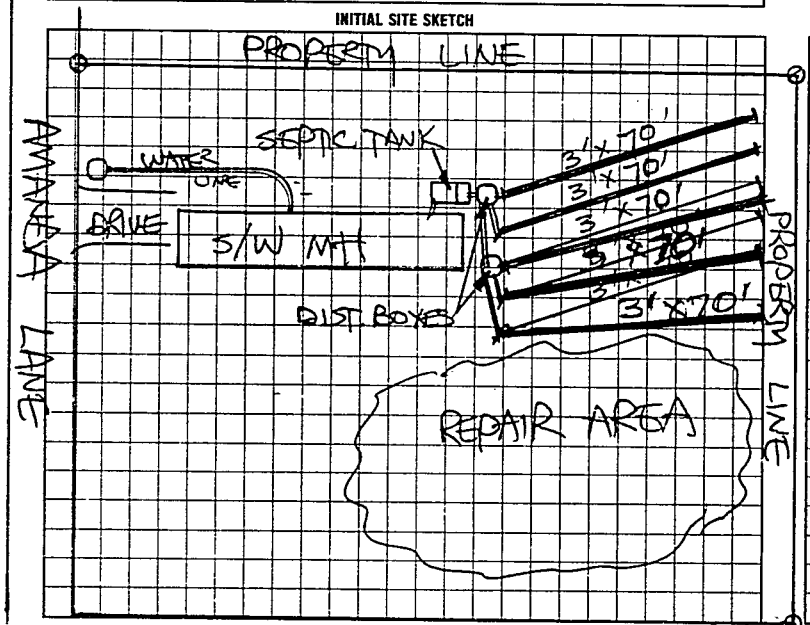

AS BUILT SKETCH

Installed as shown

I understand that this permit can be suspended or revoked if any false information is supplied toward securing the permit/any unauthorized changes are made to the site/any unauthorized changes are made in the installation of the system

AUTH. TO CONST. IS VALID FOR A PERIOD EQUAL TO THE VALIDITY OF THE I.P. NOT TO EXCEED FIVE YEARS. I.P. W/SITE PLAN IS VALID 5 YEARS

Signed: ~~Frankie Lee Sherrill~~

Installed by: A-1 Backhoe

Improvement Permit by: STEVE HEDRICK date 10-15-96

~~Authorization to Construct~~ ~~Existing System Inspection~~ by: STEVE HEDRICK date 10-15-96

~~Certificate of Completion by:~~ date

Operation Permit by: Mary CO w/ RS date 10-21-96

HEALTH DEPT. COPY: WHITE INSPECTION COPY (FINAL): GREEN OWNER COPY (FINAL): YELLOW INSPECTION COPY (INITIAL): PINK OWNER COPY (INITIAL): GOLD

0 0 2 1 8 4