* Repair

IREDELL COUNTY HEALTH DEPARTMENT

STATESVILLE 704-878-5305 MOORESVILLE 704-664-5281

IMPROVEMENT PERMIT / AUTHORIZATION TO CONSTRUCT / OPERATION PERMIT / EXISTING SYSTEM INSPECTION

*PERMIT# Repair PIN# 4716713405 DATE 8 JAN. 07

OWNER OR APPLICANT Terry Ramsey PHONE: Business Home (704) 878-2534

ADDRESS 136 Jo Monni Loop Statesville N.C.

LOCATION South Creek TL Left From N. TR 2nd entrance to Jo Monni Loop - 5th House on Rt.

SUBDIVISION BLOCK / SECTION LOT LOT AREA 0.45Ac. SITE CLASS. PS DESIGN FLOW 360gpd L.T.A.R. 0.3 gpd/ft²/day

Septic Tank: Existing Gallons: STB Date

Pump Tank: Gallons: PT Date

Pump Make: Model Serial No.

Nitrification Field: No Fields 1 Square Feet 820 Linear Feet 205'

No Lines 3 Trench Width 3' Max Trench Bottom Depth 36"

☐ New System ☑ Repair ☐ Expansion System Type: I II III IV V VI

System Description: 25% Reduction

Repair System Description:

Maintenance Agreement Required: ☐ Yes ☑ No

☑ House/Mod. Home No. Bedrooms 3

☐ Mobile Home No. Persons

☐ Business No. Employees

☐ Other


Water Supply: ☐ Individual ☑ Public ☐ Community

Gravel Depth N/A ☐ Gravity ☐ Pressure ☐ Slab ☑ Crawl Space ☐ Basement w/plumbing ☐ Basement wo/plumbing

Comments:/Conditions: Add 820 Ft² to existing system. Use 3 drop-boxes. * Clean out diversion ditch above system AND redirect water away from system. * Install ball-valve type valve.

Comments:/Conditions: New Tee installed. No valve - exist. system did not have D-Box

INITIAL SITE SKETCH * not to scale

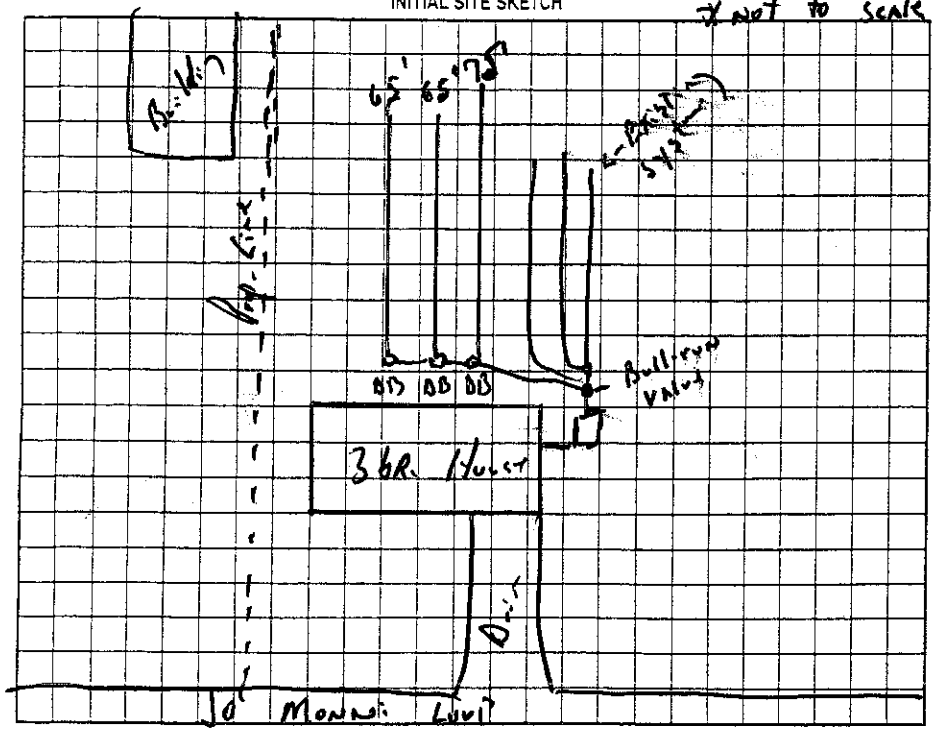

AS BUILT SKETCH

* Did not use drop-boxes.

Permit can be suspended or revoked if any false information is supplied toward securing the permit/any unauthorized changes are made to the site/any unauthorized changes are made in the installation of the system. Improvement Permit with plat valid without expiration ☐ Improvement Permit with site plan valid for sixty months ☐ Authorization to Construct is valid for a period equal to that of Improvement Permit – not to exceed sixty months.

Signed: Terry Ramsey date 01/15/07 Installed by: Dennis Callahan

Improvement Permit by: date Operation Permit by: R.S. date 24 JAN. 07

Authorization to Construct by: R.S. date 8 JAN. 07 Existing System Inspection by: date

HEALTH DEPT. COPY: WHITE OWNER COPY (FINAL): YELLOW OWNER COPY (INITIAL): PINK