IREDELL COUNTY HEALTH DEPARTMENT

(SEPTIC TANK) IMPROVEMENTS PERMIT AND CERTIFICATE OF COMPLETION
(Ground Absorption Sewage Disposal System – G. S. Chapter 130-Article 13C)

OWNER OR CONTRACTOR Larry Jenkins DATE 9/22/78 PERMIT NO. _____

PHONE: Business _____ Home _____

LOCATION Hwy #90 to Laray. T.R. on RD #1548. T.L. on RD #1648 2nd House on Rt.

SUBDIVISION NAME Jo Moni Acres S. R. No. _____

LOT NO 7-18-19-20 SECTION OR BLOCK NO. _____

House (✓) Mobile Home ( ) Business ( ) Other _____

No. Bedrooms 3 No. Bathrooms 1½

Garbage Disposal Unit	Yes ( )	No (✓)
Auto. Dishwasher	Yes ( )	No (✓)
Auto. Wash. Machine	Yes (✓)	No ( )
Site Suitable	Yes (✓)	No ( )

Lot Area 20000 Sq ft


Character & Porosity of Soil Prov. Suitable - Poor

Percolation Rate _____

Topography Slight Slope

Depth to Water Table Low

Rock or other impervious formations None

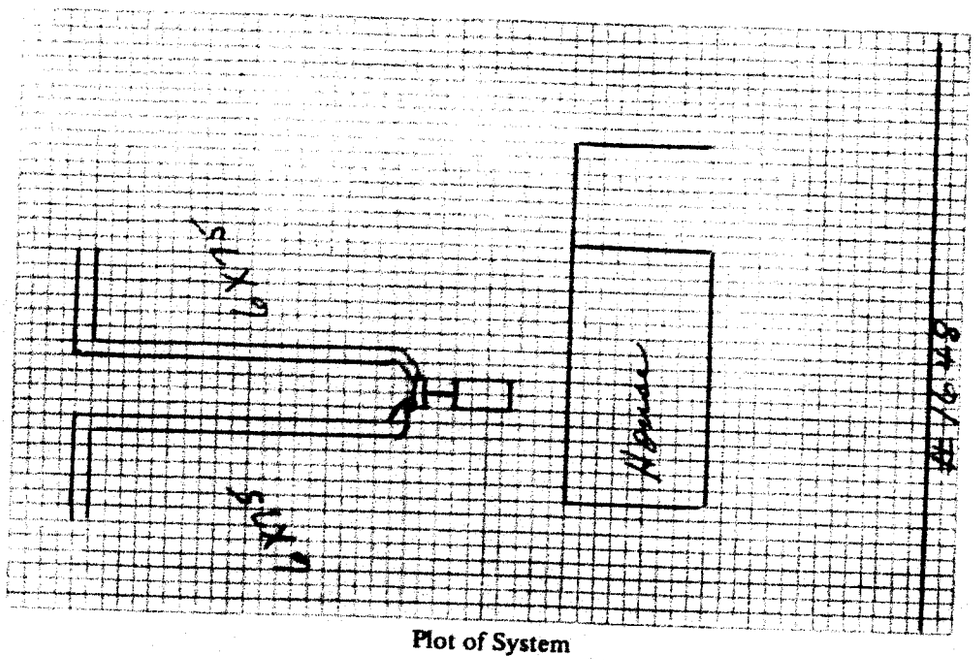

Plot of System

Size of Tank 1250 Gals.

Nitrification Field:
No. of Lines as shown
Sq. Ft. 900 Linear Ft. 300
Depth of Stone in Lines 16"

Water Supply: Individual ( )
Public (✓)

Installed by Lackey Construction
Ken Lackey -
Not Harlee or Donald

IMPROVEMENTS PERMIT BY _____

COMMENTS: Lines are deep - Not Put in as laid out.

CERTIFICATE OF COMPLETION BY E. A. Stutts Inson DATE 9/22/78

CONSTRUCTION MUST COMPLY WITH ALL OTHER APPLICABLE STATE AND LOCAL REGULATIONS.

Health Dept. Copy: White Inspection Dept. Copy: Yellow Sanitarian's Copy: Pink Owner's Copy: Gold