# IREDELL COUNTY HEALTH DEPARTMENT

STATESVILLE 704-878-5305 MOORESVILLE 704-664-5281

## IMPROVEMENT PERMIT / AUTHORIZATION TO CONSTRUCT / OPERATION PERMIT / EXISTING SYSTEM INSPECTION

PERMIT# Repair PIN# 4716-11-9101 DATE 9/30/02

OWNER OR CONTRACTOR Fannie B. Stewart PHONE: Business (704) 878-3041 Home (704) 873-5558

ADDRESS 273 Little Farm Rd. Statesville N.C. 28625

LOCATION

SUBDIVISION Jo Monni BLOCK / SECTION — LOT LOT AREA 20,000 Sq. Ft. SITE CLASS. Ex. DESIGN FLOW 360 L.T.A.R. Ex.

Septic Tank: 1000 Gallons; STB 1067 Date 1-31-02
Pump Tank: Gallons; PT Date
Pump Make: Model Serial No.
Nitrification Field: No Fields Ex. Square Feet Ex. Linear Feet Ex.
No Lines Existing Trench Width Ex. Max Trench Bottom Depth Ex. Gravel Depth

☐ New System ☒ Repair System Type: I (II) III IV V VI
System Description: Gravity, Conv.
Repair System Description:
Maintenance Agreement Required: ☐ Yes ☒ No


☒ House/Mod. Home No. Bedrooms 3
☐ Mobile Home No. Bathrooms 2
☐ Business No. Employees
☐ Other

☐ Slab ☐ Crawl Space ☒ Basement w/plumbing ☐ Basement wo/plumbing

Water Supply: ☐ Individual ☒ Public ☐ Community


Comments/Conditions: (1) Pump Septic Tank (2) Replace Existing Septic Tank w/ New Tank

INITIAL SITE SKETCH Not to Scale

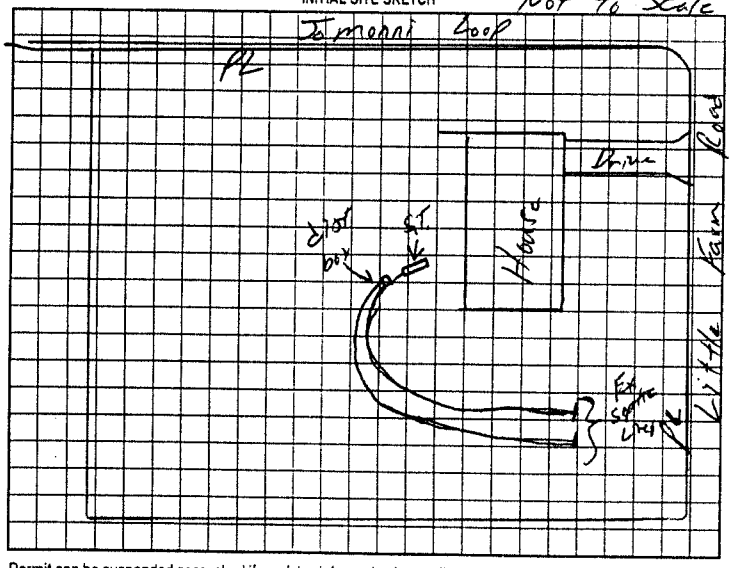


Comments/Conditions: TANK CRUSHED

AS BUILT SKETCH FILLED

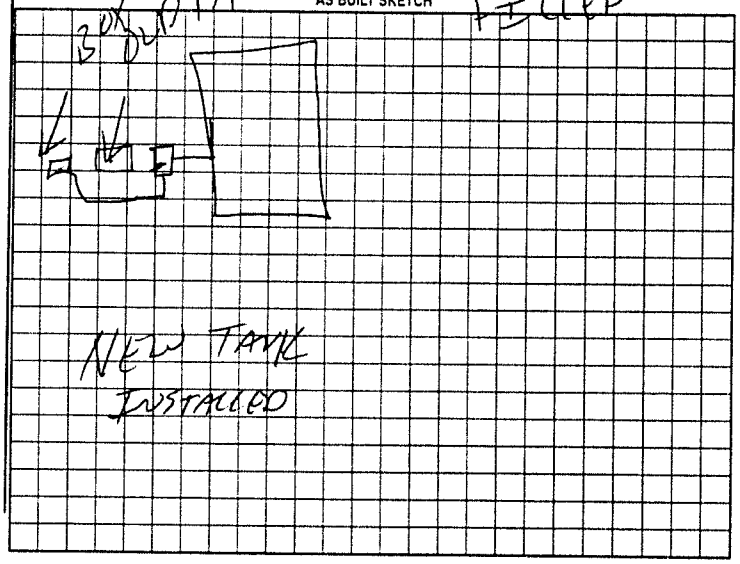


Permit can be suspended or revoked if any false information is supplied toward securing the permit/any unauthorized changes are made to the site/any unauthorized changes are made in the installation of the system. Improvement Permit with plat valid without expiration. Improvement Permit with site plan valid for sixty months. Authorization to Construct is valid for a period equal to that of Improvement Permit - not to exceed sixty months.

Signed: Fannie B Stewart date

Improvement Permit by: William E. Johnson date 9/30/02

Authorization to Construct by: William E. Johnson date 9/30/02

Installed by: JOEY DAVIS

Operation Permit by: [signature] date 10-16-02

Existing System Inspection by: date

HEALTH DEPT. COPY: WHITE OWNER COPY (FINAL): YELLOW OWNER COPY (INITIAL): PINK