Melvin Brown

IREDELL COUNTY HEALTH DEPARTMENT

Statesville Phone TR 3-7271 Mooresville Phone NO 3-1271

PERMIT TO INSTALL SEPTIC TANK

Permit No. 175 Permit Date _____ 19__

Owner Melvin Brown George McMahaffey Address Statesville

Installed By Dan & Jim Lackey Address Stony Point

Location of Property Jo-Mona Acres / Lot 11

House on corner, Community water.


McHaffey Creek Knox Lot-11

Tank		Capacity		Length of Lines		Fixtures	
Block	( )	1000	( )	225'	( )	No. of Baths	2½
Precast	(✓)	1250	( )	250'	( )	Dishwasher	( )
		1500	( )	Other 24-1		Garbage Grdr.	( )
		Other _____				Other _____	

✓2 3 2114 NOTIFY HEALTH DEPARTMENT AT LEAST EIGHT HOURS BEFORE TANK IS TO BE INSPECTED.

Final Inspection 9-14-19 71 Approved (✓) Disapproved ( )

Remarks _____

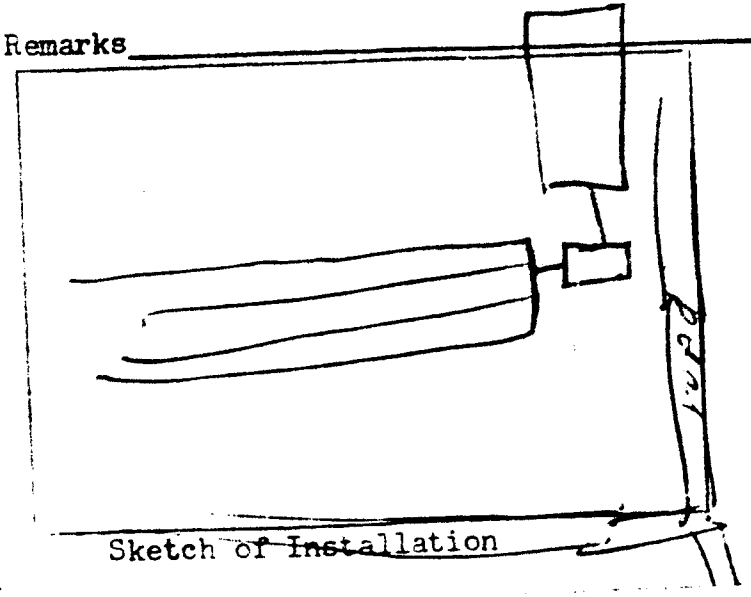

Sketch of Installation

Carl E. Hall

Sanitarian