IREDELL COUNTY HEALTH DEPARTMENT

STATESVILLE 704-878-5305 MOORESVILLE 704-664-5281

IMPROVEMENT PERMIT / AUTHORIZATION TO CONSTRUCT / OPERATION PERMIT / EXISTING SYSTEM INSPECTION

PERMIT# 08169 PIN# 4716734035 DATE 5-15-99

OWNER OR CONTRACTOR CRANDALL & O'BRIEN CONST. PHONE: Business 871-1536 Home

ADDRESS 310 TREEBARK ROAD STATESVILLE NC 28625

LOCATION NC 90 W, TR LITTLE FARM RD, TL WHEATLAND LANE, 6TH LOTS ON LEFT

SUBDIVISION SUMMERSET BLOCK / SECTION LOT 6 & 7 LOT AREA 0.850 ACRE SITE CLASS PS DESIGN FLOW 360 L.T.A.R. 0.25 GPD/FT²

Septic Tank: 1000 Gallons; STB 1012 Date 8-28-99

Pump Tank: Gallons; PT Date

Pump Make: Model Serial No.

Nitrification Field: No Fields 1 Square Feet 1440 Linear Feet 3607

No Lines SIX Trench Width 36" Max Trench Bottom Depth 30" Gravel Depth 24 & 36"

☑ New System ☐ Repair System Type: I. II (III) IV. V. VI

System Description: CHAMBERED GRAVITY (25% REDUCTION)

Repair System Description: 50% REDUCTION SYSTEM

Maintenance Agreement Required: ☐ Yes ☑ No

☑ House/Mod. Home ☐ Mobile Home ☐ Business ☐ Other


No. Bedrooms 3 No. Bathrooms 2 No. Employees

☐ Slab ☑ Crawl Space ☐ Basement w/plumbing ☐ Basement wo/plumbing

Water Supply: ☐ Individual ☑ Public ☐ Community

Comments/Conditions: INSTALL 25% REDUCTION SYSTEM USING 60 CHAMBERS OR 36 HDS SECTIONS.

INITIAL SITE SKETCH

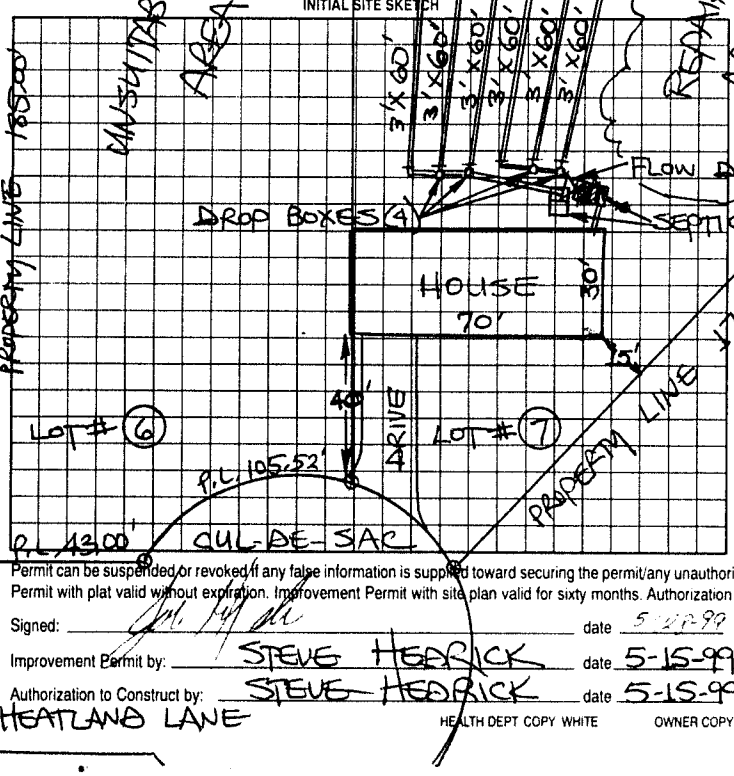

Comments/Conditions: SEPTIC TANK WITH RISERS AND MARKER INSTALLED USING "POLYLOK" TEE @ UPPER LINE INSTALLED TOOL DEEP

AS BUILT SKETCH

(3) SYSTEM INSTALLED DURING PERIOD OF WET SOIL CONDITIONS

AS SHOWN

Permit can be suspended or revoked if any false information is supplied toward securing the permit/any unauthorized changes are made to the site/any unauthorized changes are made in the installation of the system. Improvement Permit with plat valid without expiration. Improvement Permit with site plan valid for sixty months. Authorization to Construct is valid for a period equal to that of Improvement Permit – not to exceed sixty months.

Signed: date 5-17-99 Installed by: A-1 BACKHOE

Improvement Permit by: STEVE HEDRICK date 5-15-99 Operation Permit by: STEVE HEDRICK date 12-7-99

Authorization to Construct by: STEVE HEDRICK date 5-15-99 Existing System Inspection by: date

WHEATLAND LANE

HEALTH DEPT COPY WHITE OWNER COPY (FINAL) YELLOW OWNER COPY (INITIAL) PINK