IREDELL COUNTY HEALTH DEPARTMENT

STATESVILLE 704-878-5305 MOORESVILLE 704-664-5281

IMPROVEMENT PERMIT / AUTHORIZATION TO CONSTRUCT / OPERATION PERMIT / EXISTING SYSTEM INSPECTION

PERMIT# REPAIR PIN# 4716 73 4629 DATE 5-5-2000

OWNER OR CONTRACTOR MICHAEL JOHNSON PHONE: Business Home

ADDRESS 128 HAYWORTH LANE, STATESVILLE, NC 28625

LOCATION NC 115 N, TL SCOTTS CREEK RD, TL LITTLE FARM RD, TR HAYWORTH DRIVE, AT END ON RIGHT

SUBDIVISION SUMMERSET BLOCK / SECTION LOT 23 LOT AREA 0.52 ACRE SITE CLASS 15 DESIGN FLOW 360 L.T.A.R. EXISTING

Septic Tank: EXISTING Gallons; STB Date

Pump Tank: Gallons; PT Date

Pump Make: Model Serial No.

Nitrification Field: No Fields — Square Feet Linear Feet EXISTING

No Lines — Trench Width Max Trench Bottom Depth

☐ New System ☑ Repair System Type: I II III IV V VI

System Description:

Repair System Description: CONDITIONS TO INITIAL

Maintenance Agreement Required: ☐ Yes ☑ No

Gravel Depth W/6" SURFACE Slab ☐ Crawl Space ☐ Basement w/plumbing ☐ Basement wo/plumbing

☐ House/Mod. Home No. Bedrooms 3

☐ Mobile Home No. Bathrooms 2

☐ Business No. Employees


☐ Other

Water Supply: ☐ Individual ☑ Public ☐ Community


Comments/Conditions: ① PROVIDE DRAINAGE AWAY FROM SYSTEM BY GRADING AND LANDSCAPING ② INSTALL SUB-SURFACE INTERCEPT DRAINAGE DITCH WITH FALL TOWARDS SUMP PUMP – PIPED OUT TO STREET DITCH

Comments/Conditions: FALL IN DRAINAGE DITCH REVERSED AS SHOWN WITH PRIOR HEALTH DEPT. APPROVAL

INITIAL SITE SKETCH

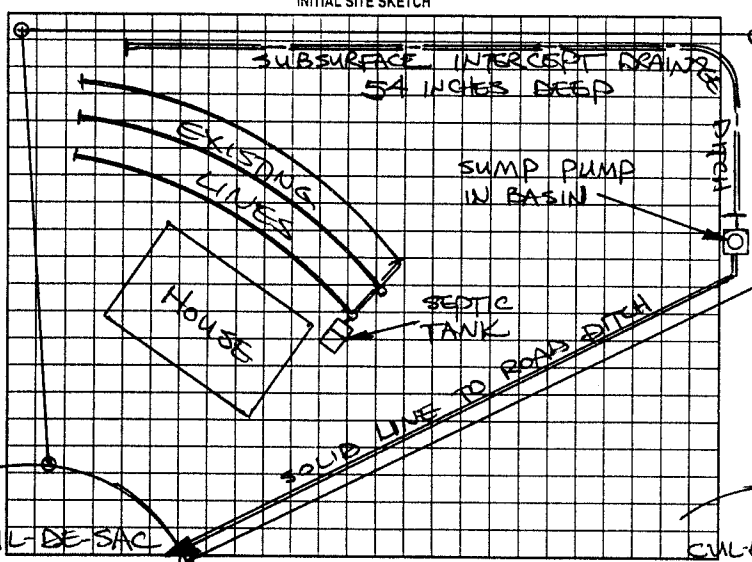

AS BUILT SKETCH

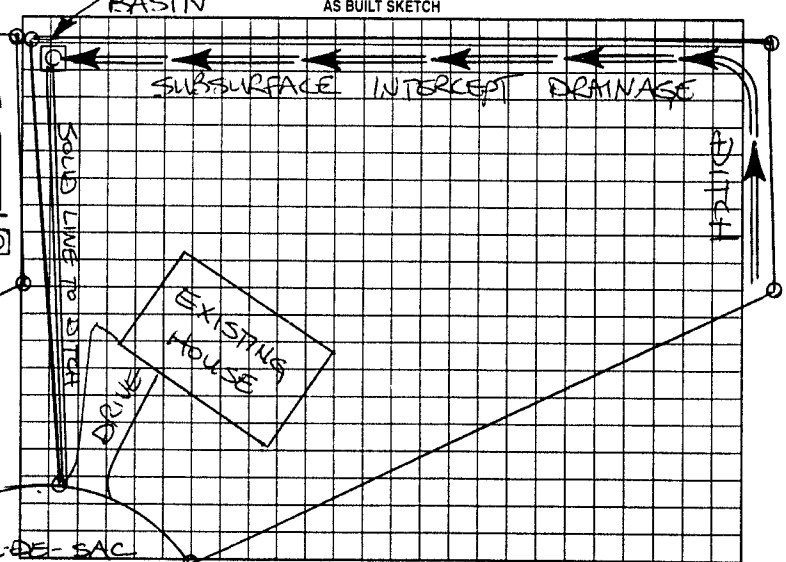

Permit can be suspended or revoked if any false information is supplied toward securing the permit/any unauthorized changes are made to the site/any unauthorized changes are made in the installation of the system. Improvement Permit with plat valid without expiration. Improvement Permit with site plan valid for sixty months. Authorization to Construct is valid for a period equal to that of Improvement Permit – not to exceed sixty months.

Signed: date

Improvement Permit by: STEVE HEDRICK date 5-5-2000

Authorization to Construct by: STEVE HEDRICK date 5-5-2000

Installed by: CRANDALL & O'BRIEN CONSTRUCTION

Operation Permit by: STEVE HEDRICK date 5-1-01

Existing System Inspection by: date

HEALTH DEPT. COPY: WHITE OWNER COPY (FINAL): YELLOW OWNER COPY (INITIAL): PINK