IREDELL COUNTY HEALTH DEPARTMENT

STATESVILLE 704-878-5305 MOORESVILLE 704-664-5281

IMPROVEMENT PERMIT / AUTHORIZATION TO CONSTRUCT / OPERATION PERMIT / EXISTING SYSTEM INSPECTION

PERMIT# 073049 PIN# 4716 73 4629 DATE 6-27-98

OWNER OR CONTRACTOR CRANDALL & O'BRIEN CONST. PHONE: Business 871-1536 Home

ADDRESS 310 TREEBARK ROAD, STATESVILLE NC 28677

LOCATION NC 90 W TR LITTLE FARM ROAD TL HAYWORTH DRIVE, AT END ON RIGHT

SUBDIVISION SUMMERSET BLOCK / SECTION LOT 23 LOT AREA 0.52 ACRE SITE CLASS. PS DESIGN FLOW 360 L.T.A.R. 0.30 GPD/FT²

Septic Tank: 1000 Gallons; STB 1012 Date 7-18-98
Pump Tank: Gallons; PT Date
Pump Make: Model Serial No.
Nitrification Field: No Fields 1 Square Feet EQ. TO 1200 Linear Feet 300+
No Lines THREE Trench Width 36" Max Trench Bottom Depth 36" ~~Gravel~~ Depth SAND 6"

☑ New System ☐ Repair System Type: I, II, (III), IV, V, VI
System Description: CHAMBERED GRAVITY
Repair System Description: CHAMBERED PUMP
Maintenance Agreement Required: ☐ Yes ☑ No ORDERED


☑ House/Mod. Home No. Bedrooms 3
☐ Mobile Home No. Bathrooms 2
☐ Business No. Employees
☐ Other
☐ Slab ☑ Crawl Space ☐ Basement w/plumbing ☐ Basement wo/plumbing

Water Supply: ☐ Individual ☑ Public ☐ Community


Comments:/Conditions: ① SET SEPTIC TANK AT GRADE TO INSURE LINE DEPTH OF 36" OR LESS ② INSTALL FIFTY CHAMBERS IN THREE LINES AS SHOWN ③ SCOUR TRENCH SIDEWALLS & APPLY LIME PRIOR TO INSTALLING CHAMBERS

Comments:/Conditions:
* Note Tank held at ground level last line slightly deeper

INITIAL SITE SKETCH SCALE: 1"=40'

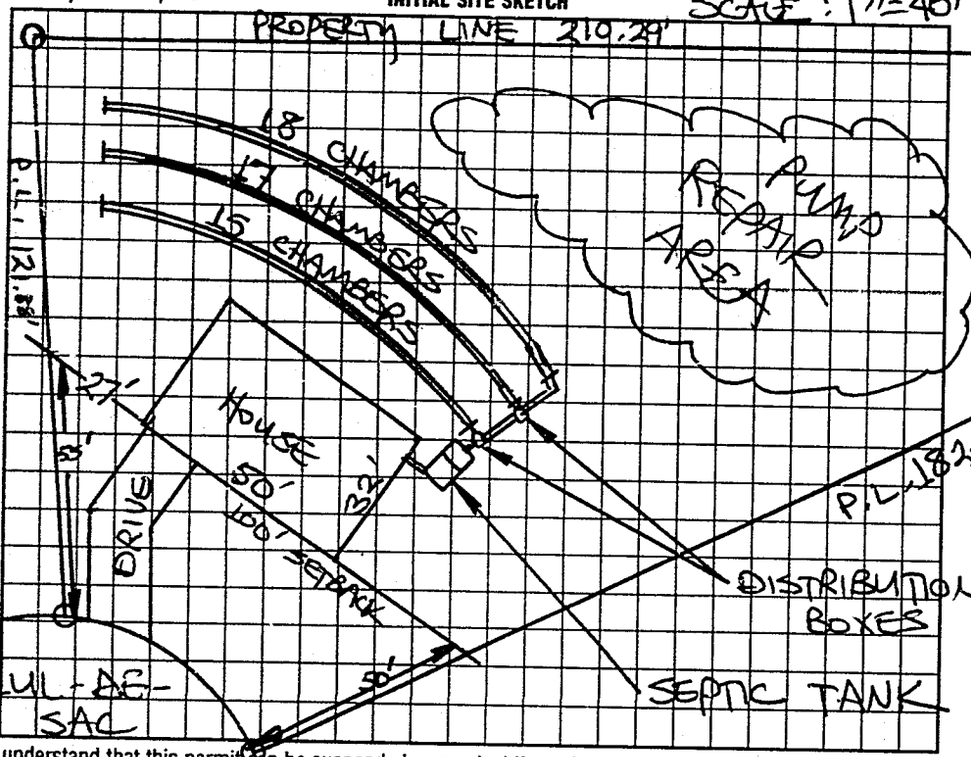

AS BUILT SKETCH

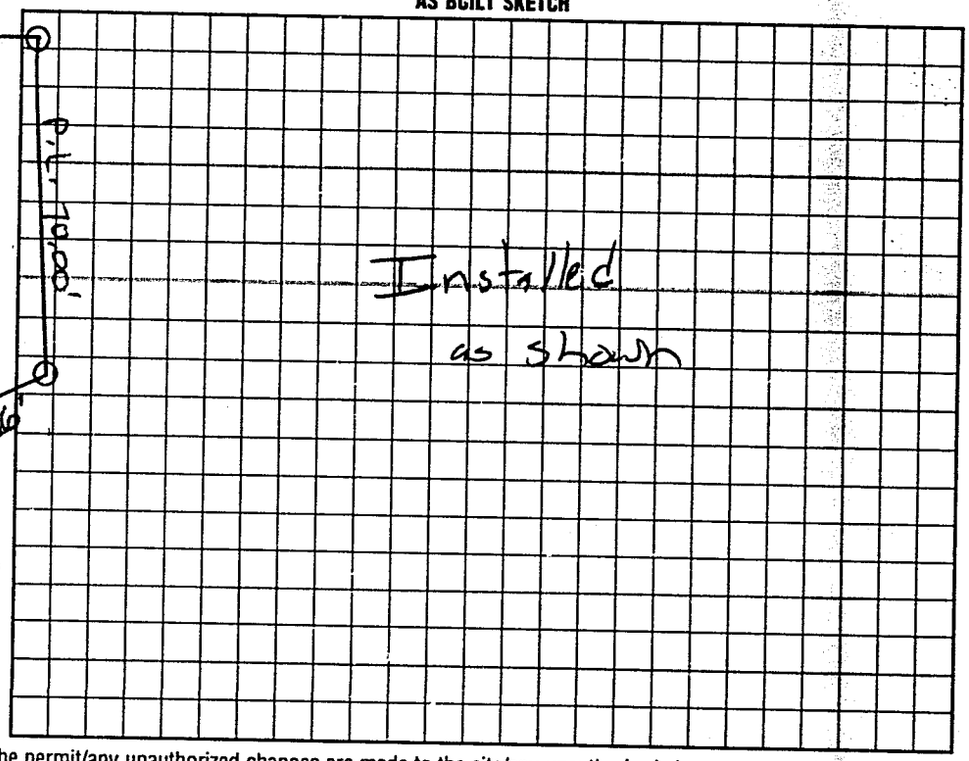

I understand that this permit can be suspended or revoked if any false information is supplied toward securing the permit/any unauthorized changes are made to the site/any unauthorized changes are made in the installation of the system. Improvement Permit with plat valid without expiration. Improvement Permit with site plan valid for sixty months. Authorization to Construct is valid for a period equal to that of Improvement Permit – not to exceed sixty months.

Signed: date 6-30-98

Improvement Permit by: STEVE HEDRICK date 6-27-98

Authorization to Construct by: STEVE HEDRICK date 6-27-98

Installed by: A-1 Backhoe

Operation Permit by: Mark Cluff RS date 9-22-98

Existing System Inspection by: date

HEALTH DEPT. COPY: WHITE INSPECTION COPY (FINAL): GREEN OWNER COPY (FINAL): YELLOW INSPECTION COPY (INITIAL): PINK OWNER COPY (INITIAL): GOLD