IREDELL COUNTY HEALTH DEPARTMENT

STATESVILLE 704-878-5305 MOORESVILLE 704-664-5281

IMPROVEMENT PERMIT / AUTHORIZATION TO CONSTRUCT / OPERATION PERMIT / EXISTING SYSTEM INSPECTION

PERMIT# 073047 PIN# 4716 73 5428 DATE 5-26-98

OWNER OR CONTRACTOR CRANDALL O'BRIEN CONST. PHONE: Business 871-1536 Home

ADDRESS 310 TREE BARK ROAD STATESVILLE, NC 28625

LOCATION NC 90 WEST, TR LITTLE FARM ROAD, TL HAYWORTH DRIVE, 6TH LOT ON LEFT

SUBDIVISION SUMMERSET BLOCK / SECTION LOT 21 LOT AREA 0.447 ACRE SITE CLASS PS DESIGN FLOW 360 L.T.A.R. [redacted] 0.30 GPD

Septic Tank: 1000 Gallons; STB Date 5-8-99
Pump Tank: Gallons; PT Date
Pump Make: Model Serial No.
Nitrification Field: No Fields 1 Square Feet EQ. TO 1200 Linear Feet 300+
No Lines FIVE Trench Width 36" Max Trench Bottom Depth 36"

☑ New System ☐ Repair System Type: I. II. III. IV. V. VI
System Description: CHAMBERED, GRAVITY
Repair System Description: PPBPS, 1 PP
Maintenance Agreement Required: ☐ Yes ☑ No
~~Gravel~~ Depth SAND 6" ☐ Slab ☑ Crawl Space ☐ Basement w/plumbing ☐ Basement wo/plumbing


☑ House/Mod. Home No. Bedrooms 3
☐ Mobile Home No. Bathrooms 2
☐ Business No. Employees
☐ Other

Water Supply: ☐ Individual ■ Public ☐ Community


Comments:/Conditions: INSTALL FIFTY (50) CHAMBERS IN FIVE EQUAL LENGTH LINES ON CONTOUR AS SHOWN

Comments:/Conditions:

INITIAL SITE SKETCH SCALE: 1" = 40'

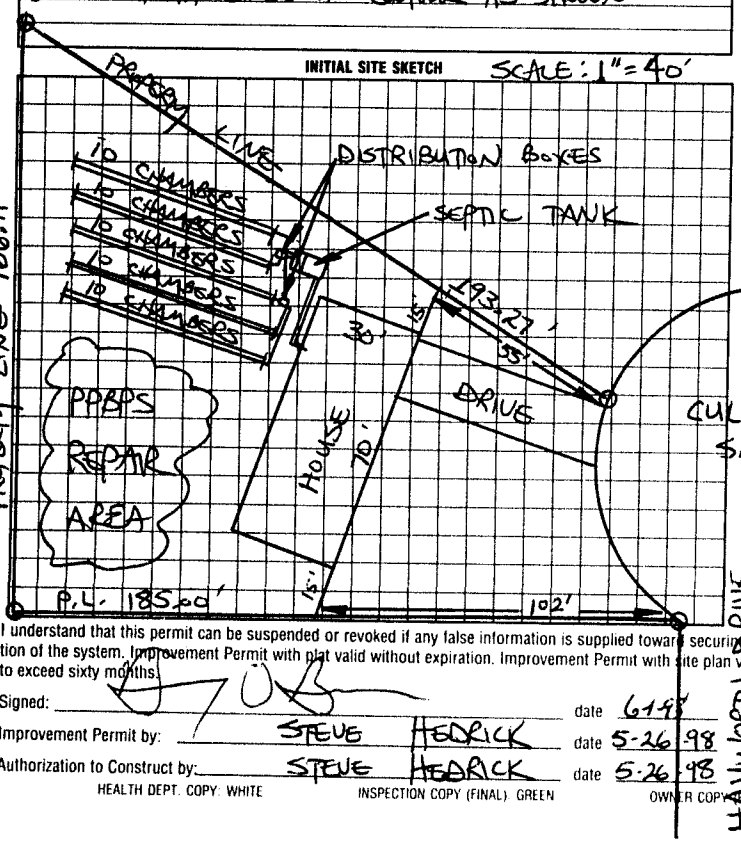

AS BUILT SKETCH

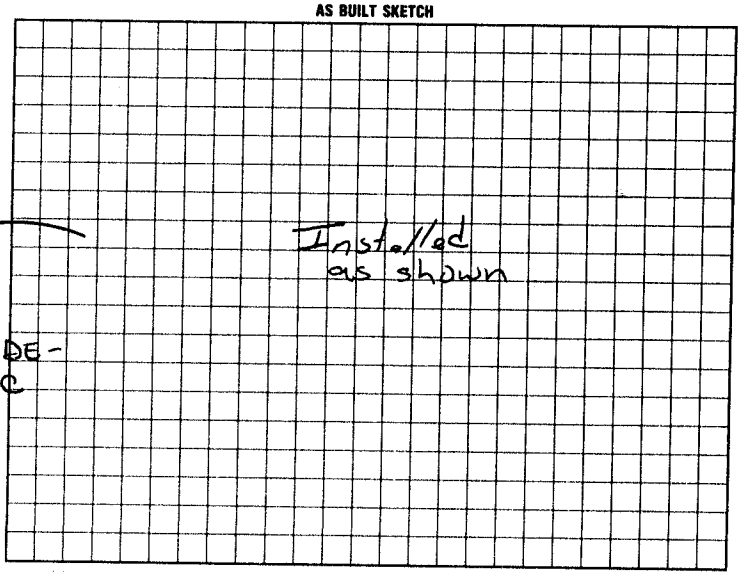

I understand that this permit can be suspended or revoked if any false information is supplied toward securing the permit/any unauthorized changes are made to the site/any unauthorized changes are made in the installation of the system. Improvement Permit with plat valid without expiration. Improvement Permit with site plan valid for sixty months. Authorization to Construct is valid for a period equal to that of Improvement Permit – not to exceed sixty months.

Signed: date 6/1/98

Improvement Permit by: STEVE HEDRICK date 5-26-98

Authorization to Construct by: STEVE HEDRICK date 5-26-98

Installed by: A-1 Backhoe

Operation Permit by: [signature] date 7-14-99

Existing System Inspection by: date

HEALTH DEPT. COPY: WHITE INSPECTION COPY (FINAL): GREEN OWNER COPY (FINAL): YELLOW INSPECTION COPY (INITIAL): PINK OWNER COPY (INITIAL): GOLD