IREDELL COUNTY HEALTH DEPARTMENT

THIS PERMIT VOIDS PREVIOUS ISSUED 1-23-99

STATESVILLE 704-878-5305 MOORESVILLE 704-664-5281

IMPROVEMENT PERMIT / AUTHORIZATION TO CONSTRUCT / OPERATION PERMIT / EXISTING SYSTEM INSPECTION

PERMIT# 073050 PIN# 4716 73 5733 DATE 7-13-99

OWNER OR CONTRACTOR CRANDALL & O'BRIEN CONST. PHONE: Business 871-1536 Home

ADDRESS 310 TREE BARK ROAD STATESVILLE, NC 28625

LOCATION NC 115 N TO SCOTTS CREEK, TL LITTLE FARM, TR HAYWORTH, 6TH LOT ON RIGHT

SUBDIVISION SUMMERSET BLOCK / SECTION LOT 24 LOT AREA 0.416 ACRE SITE CLASS PS DESIGN FLOW 360 L.T.A.R. 0.30 GPD/FT²

Septic Tank: 1000 Gallons; STB 1012 Date 7-31-99

Pump Tank: 1000 Gallons; PT 17 Date 1-18-99

Pump Make: HYDROMATIC Model SK50A1 Serial No.

Nitrification Field: No. Fields 1 Square Feet EQ TO 1209 Linear Feet 300'

No. Lines FOUR Trench Width 36" Max Trench Bottom Depth 36" Gravel Depth 12"

☒ New System ☐ Repair System Type: I. II. III. IV. V. VI

System Description: 25% REDUCTION PUMP

Repair System Description: 50% REDUCTION, LP

Maintenance Agreement Required: ☐ Yes ☒ No

☒ House/Mod. Home No. Bedrooms 3

☐ Mobile Home No. Bathrooms 2

☐ Business No. Employees

☐ Other


Slab ☒ Crawl Space ☐ Basement w/plumbing ☐ Basement wo/plumbing

Water Supply: ☐ Individual ☒ Public ☐ Community

Comments/Conditions: ① INSTALL 25% REDUCTION SYSTEM USING FIFTY-TWO CHAMBERS OR THIRTY HDS SECTIONS ② SEE ATTACHED SHEETS FOR PUMP AND PRESSURE MANIFOLD REQUIREMENTS

Comments/Conditions: TANK & LINES INSPECTED 10-15-99 30 HDS SECTIONS INSTALLED AS SHOWN. SEPTIC TANK WITH RISERS INSTALLED USING "POLYLOK" FILTER

INITIAL SITE SKETCH

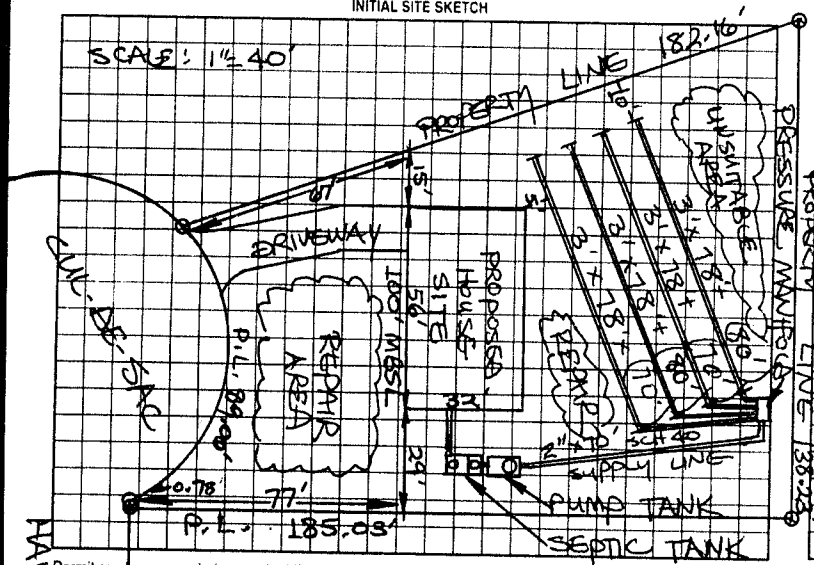

AS BUILT SKETCH

SYSTEM INSTALLED ACCORDING TO INITIAL SITE SKETCH

Permit can be suspended or revoked if any false information is supplied toward securing the permit/any unauthorized changes are made to the site/any unauthorized changes are made in the installation of the system. Improvement Permit with plat valid without expiration. Improvement Permit with site plan valid for sixty months. Authorization to Construct is valid for a period equal to that of Improvement Permit -- not to exceed sixty months.

Signed: _____ date 7-26-99 Installed by: A-1 BACKHOE

Improvement Permit by: STEVE HEDRICK date 7-13-99 Operation Permit by: STEVE HEDRICK date 10-28-99

Authorization to Construct by: STEVE HEDRICK date 7-13-99 Existing System Inspection by: _____ date _____

HEALTH DEPT COPY WHITE OWNER COPY (FINAL) YELLOW OWNER COPY (INITIAL) PINK