IREDELL COUNTY HEALTH DEPARTMENT

STATESVILLE 704-878-5305 MOORESVILLE 704-664-5281

IMPROVEMENT PERMIT / CERTIFICATE OF COMPLETION / OPERATION PERMIT / EXISTING SYSTEM INSPECTION

PROPERTY DESCRIPTION NO. 067686 DATE 7-12-97 TAX MAP NO. 4716737134

OWNER OR CONTRACTOR CRANDALL / O'BRIEN PHONE: Business 871-1536 Home

ADDRESS 296 TREEBARK ROAD, STATESVILLE, NC 28677 Watershed: ☐ Yes ☑ No

LOCATION NC 115 N, TL SCOTTS CREEK RD TL LITTLE FARM, TR SRAINGER LANE, LOT ON LEFT AT CUL-DE-SAC (LOT ON LEFT)

SUBDIVISION SUMMERSET BLOCK / SECTION LOT 35 LOT AREA 0.403 ACRE SITE CLASS. PS DESIGN FLOW 360 L.T.A.R. 0.30 GPD/FT2

Septic Tank: 1000 Gallons; STB Date 6-14-98

Pump Tank: Gallons; PT Date

Pump Make: Model Serial No.

Nitrification Field: No Fields 1 Square Feet 50 TO 1200 Linear Feet 300

No Lines FOUR Trench Width 36" Max Trench Bottom Depth 36" Gravel Depth NA

☑ New System ☐ Repair System Type: I, II, III, IV, V, VI

System Description: CHAMBERED GRAVITY

Repair System Description: PPBPS PUMP

Maintenance Agreement Required: ☐ Yes ☑ No

☑ House/Mod. Home No. Bedrooms 3

☐ Mobile Home No. Bathrooms 2

☐ Business No. Employees

☐ Other

☐ Slab ☑ Crawl Space ☐ Basement w/plumbing ☐ Basement wo/plumbing


Water Supply: ☐ Individual ☐ Community ☑ Public

Comments: INSTALL 50 CHAMBERS IN FOUR LINES AS SHOWN BELOW, ON CONTOUR.


Comments:

INITIAL SITE SKETCH

SCALE: 1" = 40'

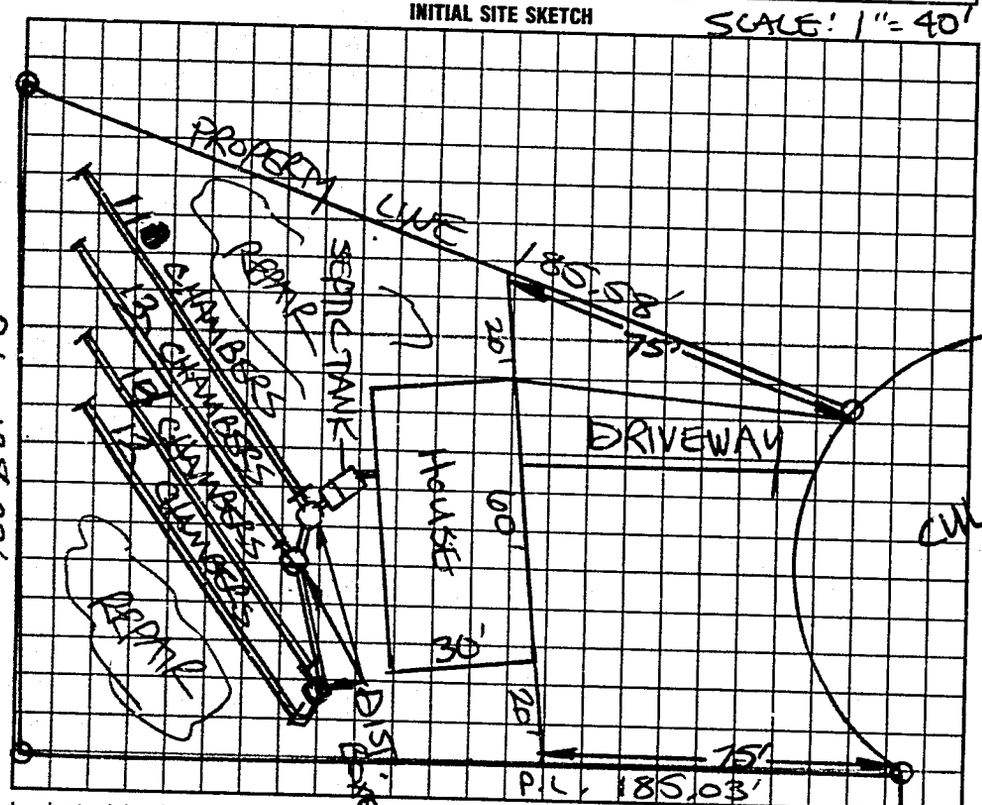

AS BUILT SKETCH

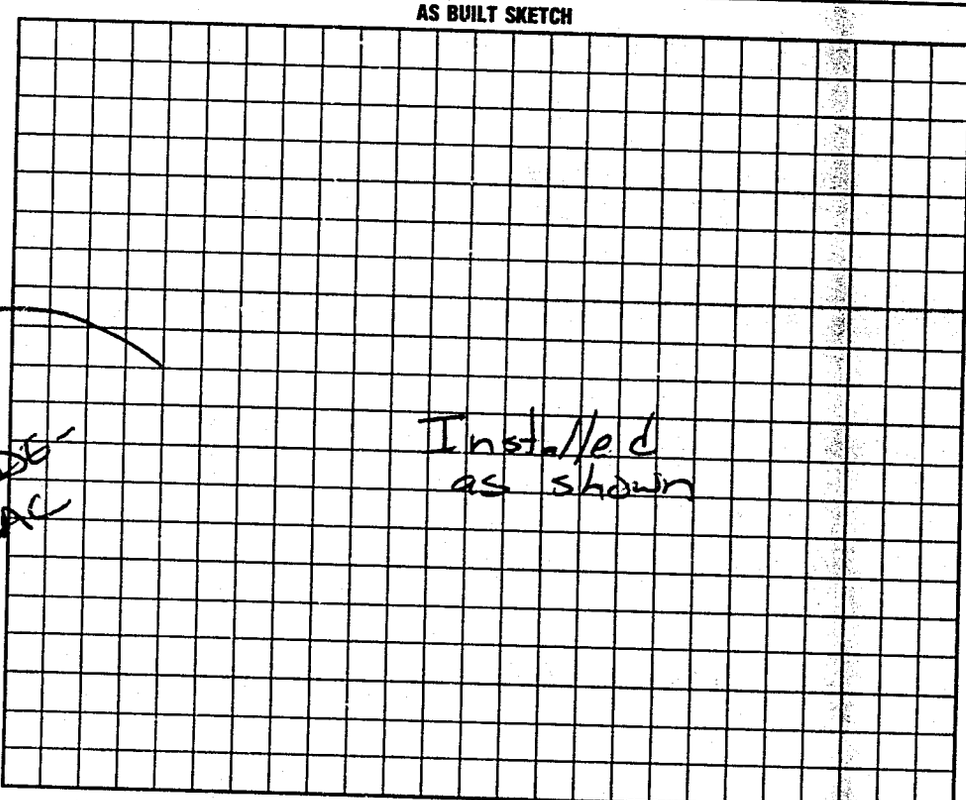

I understand that this permit can be suspended or revoked if any false information is supplied toward securing the permit/any unauthorized changes are made to the site/any unauthorized changes are made in the installation of the system. Improvement Permit is valid for 60 months from date of issuance. AUTHORIZATION TO CONSTRUCT IS VALID FOR 60 MONTHS FROM DATE OF ISSUANCE.

Signed:

Improvement Permit by: STEVE HEDRICK date 7-12-97

AUTH. TO CONST. ~~Existing System Inspection~~ by: STEVE HEDRICK date 7-12-97

Installed by: A-1

~~Certificate of Completion by:~~ date

Operation Permit by: Mark C Ont RS date 8-10-98

HEALTH DEPT. COPY: WHITE INSPECTION COPY (FINAL): GREEN OWNER COPY (FINAL): YELLOW INSPECTION COPY (INITIAL): PINK OWNER COPY (INITIAL): GOLD