IREDELL COUNTY HEALTH DEPARTMENT

STATESVILLE 704-878-5305 ~~MOORESVILLE 704-664-5281~~

IMPROVEMENT PERMIT / AUTHORIZATION TO CONSTRUCT / OPERATION PERMIT / EXISTING SYSTEM INSPECTION

PERMIT # 160406 PIN # 4716-73-6311 DATE 23 MARCH 10

OWNER or APPLICANT Carl Cranick PHONE: Business Home: 704-871-2315

OWNER or APPLICANT ADDRESS 122 Wheatland Ln Statesville

LOCATION / DIRECTIONS Scotts Creek Rd. TL Little Farm Rd TR Wheatland - on Rt- new pl.

SUBDIVISION BLOCK / SECTION LOT # 10 LOT AREA DESIGN FLOW 360 gpd L.T.A.R.

Septic Tank Exist. Gallons: STB Date

Pump Tank Gallons: P T Date

Pump Make Model Serial #

Nitrification Field No Fields 1 No Lines 5 Linear Feet 400

Trench Width 36 Max. Trench Bottom Depth Gravel Depth

☐ New System ☐ Repair ☐ Expansion System Type I II III IV V VI

System Description: Conventional

Repair System Description:

Maintenance Agreement Required ☐ YES ☒ NO

☐ GRAVITY ☑ PRESSURE

~~☐ Residence~~ No. Bedrooms 3

☐ Business No. Persons

☐ Other No. Employees

☐ Slab ☒ Crawl Space


☐ Basement w/plumbing ☐ Basement w/o plumbing

Water Supply: ☐ Private ~~☐ Public~~ ☐ Community


Comments / Conditions

Comments / Conditions

INITIAL SITE SKETCH

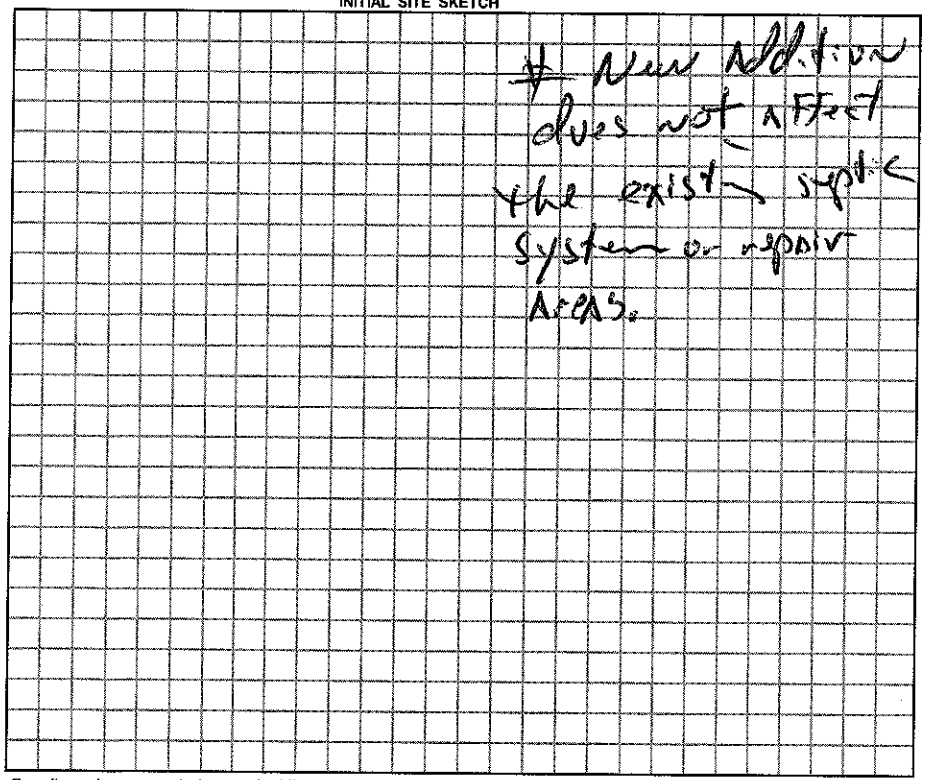

AS BUILT SKETCH

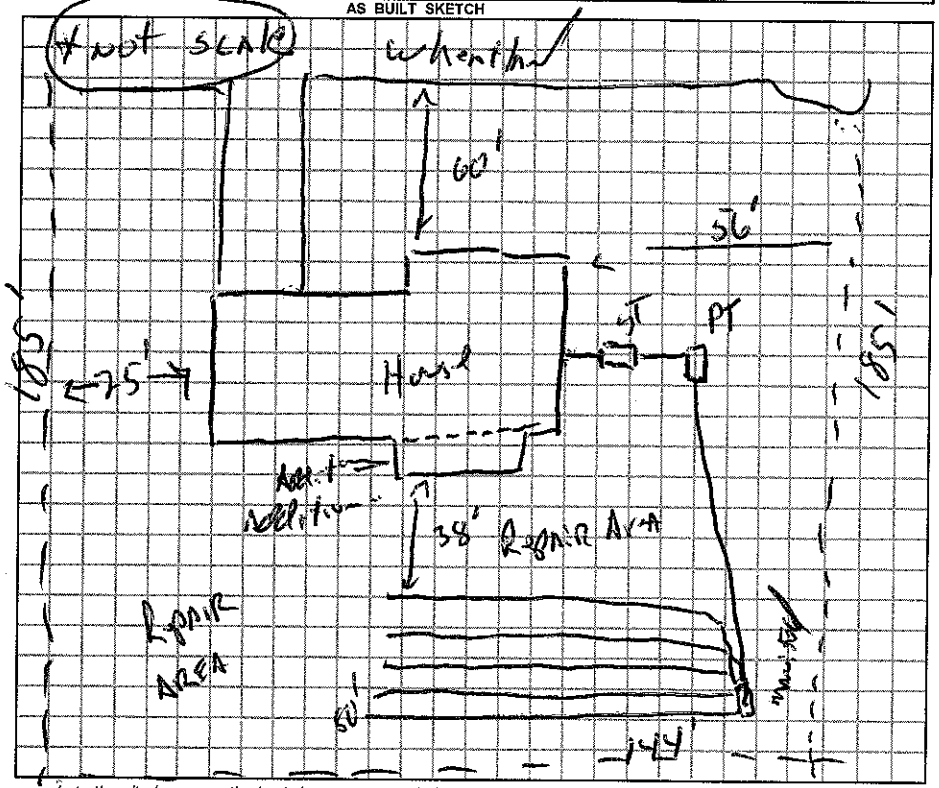

Permit can be suspended or revoked if any false information is supplied toward securing the permit / any unauthorized changes are made to the site / any unauthorized changes are made in the installation of the system.

☐ *IMPROVEMENT PERMIT w / plat valid without expiration.* ☐ *IMPROVEMENT PERMIT w / site plan valid for 60 mos.* ☐ *AUTHORIZATION TO CONSTRUCT valid for period equal to IMPROVEMENT PERMIT-not to exceed 60 mo.*

Owner / Applicant Signature: Carl Cranick Date 3-30-10

Improvement Permit by: Date

Authorzation to Construct by: Date

YOU SHOULD CONTACT A LOCATOR SERVICE PRIOR TO ANY EXCAVATION.

Installed by:

Operation Permit by: Date:

Existing System Inspected by: R.S. Date: 23 March 10

WHITE COPY Environmental Health YELLOW COPY (Final) Owner / Applicant PINK COPY (Initial) Owner / Applicant