IREDELL COUNTY HEALTH DEPARTMENT

STATESVILLE 704-878-5305 MOORESVILLE 704-664-5281

IMPROVEMENT PERMIT / AUTHORIZATION TO CONSTRUCT / OPERATION PERMIT / EXISTING SYSTEM INSPECTION

PERMIT# 073043 PIN# 4716 73 6429 DATE 5-23-98

OWNER OR CONTRACTOR CRANDALL & O'BRIEN CONST. PHONE: Business 871-1536 Home

ADDRESS 310 TREEBARK ROAD, STATESVILLE, NC 28625

LOCATION NC 90 WEST, TR LITTLE FARM ROAD, TL HAYWORTH DRIVE, 5TH LOT ON LEFT

SUBDIVISION SUMMERSET BLOCK / SECTION LOT 20 LOT AREA 0.425 ACRE SITE CLASS PS DESIGN FLOW 360 L.T.A.R. 0.30 GPD/FT²

Septic Tank: 1000 Gallons; STB 1017 Date 5-7-99

Pump Tank: Gallons; PT Date

Pump Make: Model Serial No.

Nitrification Field: No Fields 1 Square Feet SQ FT 1200 Linear Feet 300+

No Lines FIVE Trench Width 36" Max Trench Bottom Depth 36"

☑ New System ☐ Repair System Type: ☐ I ☐ II ☑ III ☐ IV ☐ V ☐ VI

System Description: CHAMBERED GRAVITY

Repair System Description: PIPES LOW PRESSURE

Maintenance Agreement Required: ☐ Yes ☑ No

☑ House/Mod. Home No. Bedrooms 3

☐ Mobile Home No. Bathrooms 2

☐ Business No. Employees

☐ Other


Water Supply: ☐ Individual ☑ Public ☐ Community

~~Gravel~~ Depth SAND 6" ☐ Slab ☑ Crawl Space ☐ Basement w/plumbing ☐ Basement wo/plumbing

Comments:/Conditions: ① SCOUR TRENCH SIDEWALLS AND APPLY A LIGHT DUSTING OF LIME PRIOR TO INSTALLING CHAMBERS ② INSTALL FIFTY (50) CHAMBERS IN FIVE EQUAL LENGTH LINES.

Comments:/Conditions:

INITIAL SITE SKETCH SCALE: 1" = 40'

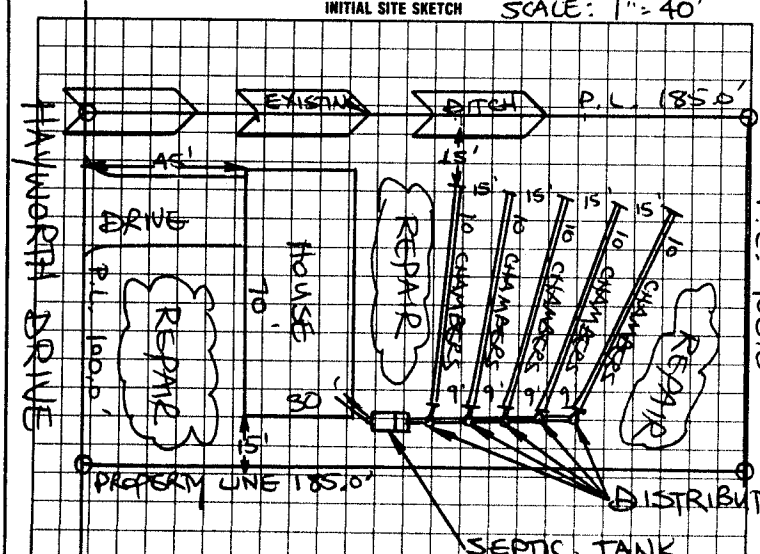

AS BUILT SKETCH

Installed as shown

I understand that this permit can be suspended or revoked if any false information is supplied toward securing the permit/any unauthorized changes are made to the site/any unauthorized changes are made in the installation of the system. Improvement Permit with plat valid without expiration. Improvement Permit with site plan valid for sixty months. Authorization to Construct is valid for a period equal to that of Improvement Permit – not to exceed sixty months.

Signed: date 6-1-98 Installed by: A-1 Backhoe

Improvement Permit by: STEVE HEDRICK date 5-23-98 Operation Permit by: Mark C Ogburn date 7-14-99

Authorization to Construct by: STEVE HEDRICK date 5-23-98 Existing System Inspection by: date

HEALTH DEPT. COPY: WHITE INSPECTION COPY (FINAL) GREEN OWNER COPY (FINAL) YELLOW INSPECTION COPY (INITIAL) PINK OWNER COPY (INITIAL) GOLD