IREDELL COUNTY HEALTH DEPARTMENT

STATESVILLE 704-878-5305 MOORESVILLE 704-664-5281

IMPROVEMENT PERMIT / AUTHORIZATION TO CONSTRUCT / OPERATION PERMIT / EXISTING SYSTEM INSPECTION

PERMIT# 073051 PIN# 4716 73 6733

OWNER OR CONTRACTOR CRANDALL AND O'BRIEN PHONE: Business 871-1536 Home DATE 5-16-98

ADDRESS 310 TREEBACK ROAD, STATESVILLE, NC 28625

LOCATION NC 90 WEST, TR LITTLE FARM ROAD, TL HAMWORTH DRIVE 5TH LOT ON RIGHT

SUBDIVISION SUMMERSET BLOCK / SECTION LOT 25 LOT AREA 0.425 ACRE SITE CLASS. PS1 DESIGN FLOW 360 L.T.A.R. 0.30 GPD/FT²

Septic Tank: 1000 Gallons; STB 1012 Date 10-5-98

Pump Tank: Gallons; PT Date

Pump Make: Model Serial No.

Nitrification Field: No Fields 1 Square Feet EQ TO 1200 Linear Feet 300+

No Lines FIVE Trench Width 36" Max Trench Bottom Depth 36" ± Gravel Depth SAND 6"

☑ New System ☐ Repair System Type: I, II, III, IV, V, VI

System Description: CHAMBERED, GRAVITY

Repair System Description: CHAMBERED, PUMP

Maintenance Agreement Required: ☐ Yes ☑ No

☑ House/Mod. Home No. Bedrooms 3

☐ Mobile Home No. Bathrooms 2

☐ Business No. Employees

☐ Other


☐ Slab ☑ Crawl Space ☐ Basement w/plumbing ☐ Basement wo/plumbing

Water Supply: ☐ Public ☐ Community


Comments:/Conditions ① INSTALL SEPTIC TANK AT GRADE TO KEEP LINES AT 36" OR LESS ② SCOUR TRENCH SIDEWALLS AND APPLY A LIGHT DUSTING OF LIME PRIOR TO INSTALLING CHAMBERS.

Comments:/Conditions:

INITIAL SITE SKETCH SCALE 1" = 30'

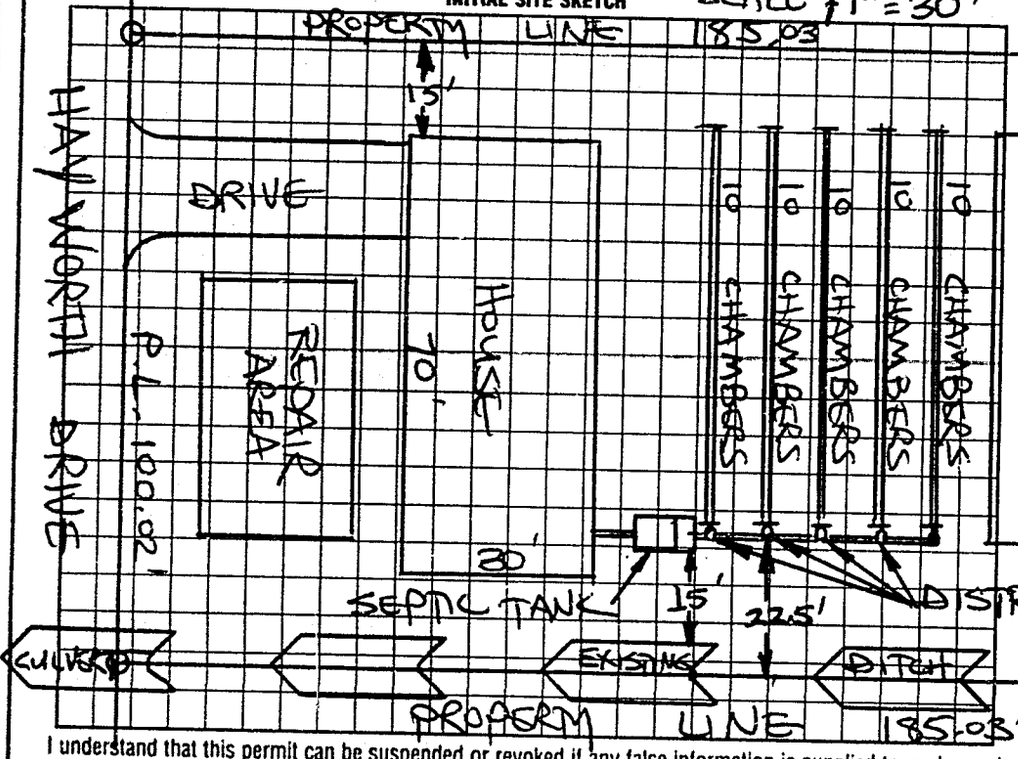

AS BUILT SKETCH

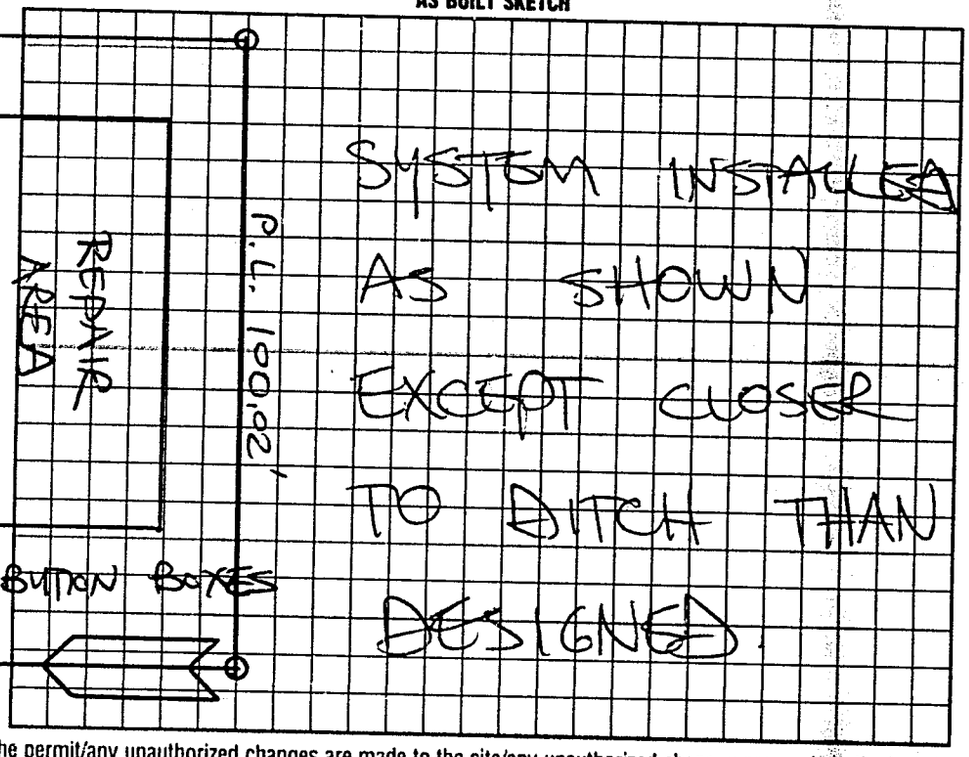

I understand that this permit can be suspended or revoked if any false information is supplied toward securing the permit/any unauthorized changes are made to the site/any unauthorized changes are made in the installation of the system. Improvement Permit with plat valid without expiration. Improvement Permit with site plan valid for sixty months. Authorization to Construct is valid for a period equal to that of Improvement Permit – not to exceed sixty months.

Signed: [signature] date 5-20-98

Improvement Permit by: STEVE HEDRICK date 5-16-98

Authorization to Construct by: STEVE HEDRICK date 5-16-98

Installed by: A-1 BACKHOE

Operation Permit by: STEVE HEDRICK date 12-15-98

Existing System Inspection by: date

HEALTH DEPT. COPY: WHITE INSPECTION COPY (FINAL): GREEN OWNER COPY (FINAL): YELLOW INSPECTION COPY (INITIAL): PINK OWNER COPY (INITIAL): GOLD