IREDELL COUNTY HEALTH DEPARTMENT

STATESVILLE 704-878-5305 MOORESVILLE 704-664-5281

IMPROVEMENT PERMIT / AUTHORIZATION TO CONSTRUCT / OPERATION PERMIT / EXISTING SYSTEM INSPECTION

PERMIT# 073052 PIN# 4716 73 7732 DATE 5-16-98

OWNER OR CONTRACTOR CRANDALL AND O'BRIEN PHONE: Business 871-1536 Home

ADDRESS 310 TREEBARK ROAD, STATESVILLE NC 28625

LOCATION NC 90 WEST, TR LITTLE FARM ROAD, TL HAYWORTH DRIVE, 4TH LOT ON RIGHT

SUBDIVISION SUMMERSET BLOCK / SECTION LOT 26 LOT AREA 0.425 ACRE SITE CLASS PS DESIGN FLOW 300 L.T.A.R. 0.30 GPD/FT²

Septic Tank: 1000 Gallons; STB 1012 Date 1-15-99
Pump Tank: Gallons; PT Date
Pump Make: Model Serial No.
Nitrification Field: No Fields 1 Square Feet EQ TO 1200 Linear Feet 300+
No Lines FIVE Trench Width 36" Max Trench Bottom Depth 36"

[X] New System [ ] Repair System Type: I, II, III, IV, V, VI
System Description: CHAMBERED GRAVITY
Repair System Description: CHAMBERED PUMP
Maintenance Agreement Required: [ ] Yes [X] No

[X] House/Mod. Home No. Bedrooms 3
[ ] Mobile Home No. Bathrooms 2
[ ] Business No. Employees
[ ] Other


~~Gravel~~ Depth SAND 6" [ ] Slab [X] Crawl Space [ ] Basement w/plumbing [ ] Basement wo/plumbing

Water Supply: [ ] Individual [X] Public [ ] Community


Comments/Conditions: ① INSTALL SEPTIC TANK AT GRADE TO KEEP LINES AT 36" OR LESS ② SCOUR TRENCH SIDEWALLS AND APPLY A LIGHT DUSTING OF LIME PRIOR TO INSTALLING CHAMBERS.

Comments/Conditions: Last 2 lines are deep.

INITIAL SITE SKETCH SCALE: 1" = 30'

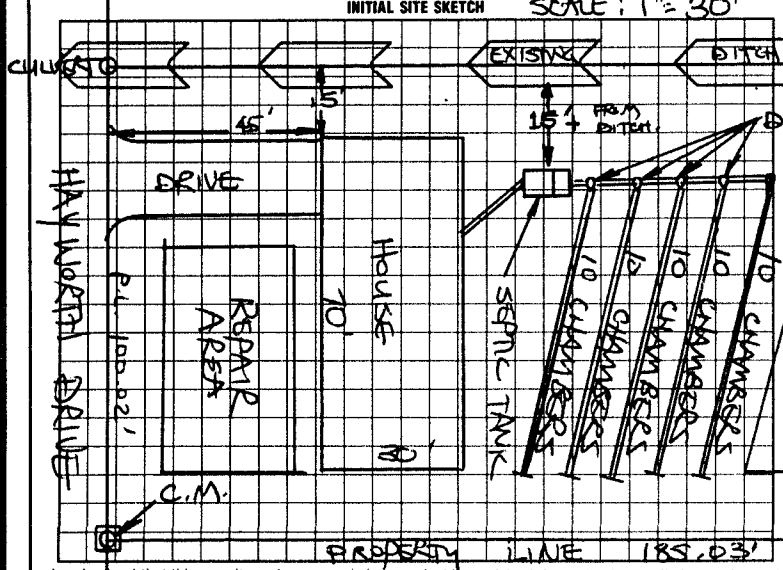

AS BUILT SKETCH

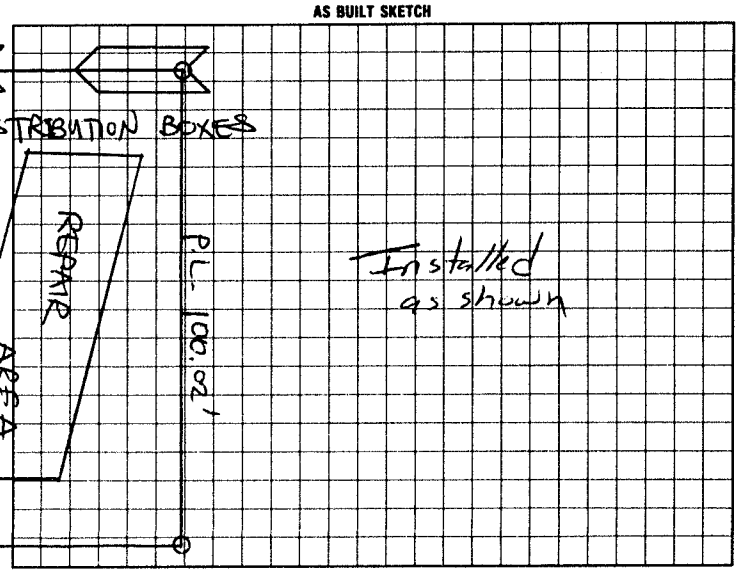

I understand that this permit can be suspended or revoked if any false information is supplied toward securing the permit/any unauthorized changes are made to the site/any unauthorized changes are made in the installation of the system. Improvement Permit with plat valid without expiration. Improvement Permit with site plan valid for sixty months. Authorization to Construct is valid for a period equal to that of Improvement Permit – not to exceed sixty months.

Signed: date 5-20-98 Installed by: A-1 Backhoe

Improvement Permit by: STEVE HEDRICK date 5-16-98 Operation Permit by: Mark Cox RS date 3-22-99

Authorization to Construct by: STEVE HEDRICK date 5-16-98 Existing System Inspection by: date

HEALTH DEPT. COPY: WHITE INSPECTION COPY (FINAL): GREEN OWNER COPY (FINAL): YELLOW INSPECTION COPY (INITIAL): PINK OWNER COPY (INITIAL): GOLD