IREDELL COUNTY HEALTH DEPARTMENT

STATESVILLE 704-878-5305 MOORESVILLE 704-664-5281

IMPROVEMENT PERMIT / AUTHORIZATION TO CONSTRUCT / OPERATION PERMIT / EXISTING SYSTEM INSPECTION

PERMIT# 070961 PIN# 4716737134 DATE Jan. 7, 98

OWNER OR CONTRACTOR Crandall & O'Brien Const. PHONE: Business 871-1536 Home

ADDRESS 279 Treebank Rd. Statesville

LOCATION 115 N. TL Scotts Creek Rd. TL Little Farm Rd. TR Grainger Ln. on left

SUBDIVISION Summerset BLOCK / SECTION 1 LOT 33 LOT AREA 100' X 185' SITE CLASS. PS DESIGN FLOW 360gpd L.T.A.R. .03

Septic Tank: 1000 Gallons; STB 10 12 Date 12-30-97
Pump Tank: Gallons; PT Date
Pump Make: Model Serial No.
Nitrification Field: No Fields 1 Square Feet 1200 Linear Feet 400
No Lines 5 Trench Width 36" Max Trench Bottom Depth 36" Gravel Depth 12"

☑ New System ☐ Repair System Type: I, II, III, IV, V, VI
System Description: Gravity Conventional
Repair System Description: Gravity Pumped Modified
Maintenance Agreement Required: ☐ Yes ☑ No

☑ House/Mod. Home No. Bedrooms 3
☐ Mobile Home No. Bathrooms 2
☐ Business No. Employees
☐ Other
☐ Slab ☑ Crawl Space ☐ Basement w/plumbing ☐ Basement wo/plumbing


Water Supply: ☐ Individual ☑ Public ☐ Community

Comments:/Conditions: Install Stormwater Diversional Ditch along 33/34 side property line.

Comments:/Conditions: Checked system Need to install stormwater Ditch - installed 5/28/98

1" = 50'

INITIAL SITE SKETCH

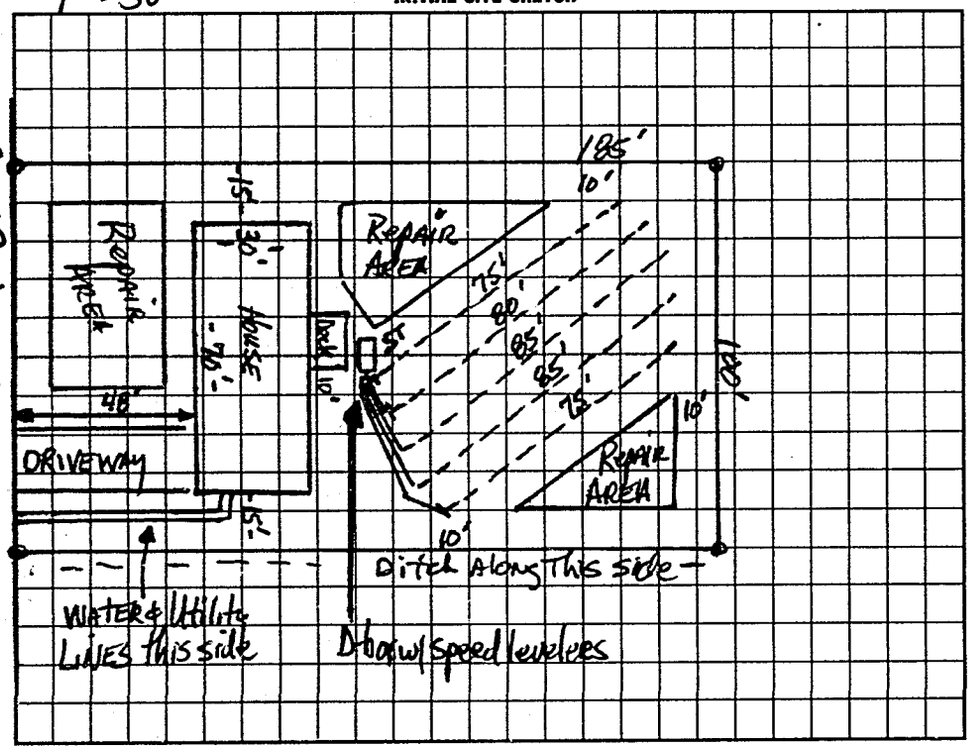

AS BUILT SKETCH

Installed as shown

I understand that this permit can be suspended or revoked if any false information is supplied toward securing the permit/any unauthorized changes are made to the site/any unauthorized changes are made in the installation of the system. Improvement Permit with plat valid without expiration. Improvement Permit with site plan valid for sixty months. Authorization to Construct is valid for a period equal to that of Improvement Permit – not to exceed sixty months.

Signed: * date

Improvement Permit by: B.R. Hinson, RS date 1-7-98

Authorization to Construct by: B.R. Hinson, RS date 1-7-98

Installed by: A-1 Backhoe

Operation Permit by: Mark C. Ott RS date 5-28-98

Existing System Inspection by: date

HEALTH DEPT. COPY: WHITE INSPECTION COPY (FINAL): GREEN OWNER COPY (FINAL): YELLOW INSPECTION COPY (INITIAL): PINK OWNER COPY (INITIAL): GOLD

999000