ICHD - ENVIRONMENTAL HEALTH DIVISION

Statesville Office (704) 878-5305 Mooresville Office (704) 660-3625 PERMIT # 2023-42856

SEPTIC: IMPROVEMENT PERMIT / AUTHORIZATION TO CONSTRUCT / OPERATION PERMIT / EXISTING SYSTEM Repair STH PIN # 4716 -- 73 -- 8732

APPLICANT/OWNER: Jeanie Lentz APPLICANT ADDRESS: 463 Lentz Rd, Statesville 28625

SITE ADDRESS: 112 Hayworth Ln, Statesville 28625 PHONE: 980-829-3278 ALT. PHONE -

SITE DIRECTIONS: 115 N - Scotts Creek - Little Farm - Hayworth SAP CONTROLLED: ☐ YES ☐ NO


SUBDIVISION: Summerset SECTION: - LOT # 27 LOT AREA: 0.43 acres DESIGN FLOW: 360 gpd L.T.A.R.: EX

Septic Tank	1000	(gal)	STB	7600	Date	11-7-23	☐ New System	☒ Repair	☐ Expansion	System Type: I II (III) IV V VI	
Pump Tank		(gal)	PT		Date		System Description:	Tank Replacement			
Pump Make			Model		Serial #		Repair System Description:				
# Nitrification Fields	EX		# Lines	EX	Linear Ft	EX	Maintenance Agreement Required:	☐ YES	☒ NO		
Trench Width	EX		Trench Bottom Depth(Low side)	EX	Gravel Depth	-		☒ GRAVITY	☐ PRESSURE		

☒ Residence	No. Bedrooms	3	Water Supply	
☐ Business	No. Persons	6	☐ Private	
☐ Other	No. Employees		☒ Public	
☐ Slab	☒ Crawl Space		☐ Community	
☐ Basement w/plumbing			☐ Basement w/o plumbing	

Comments / Conditions: Pump, crush, & fill old tank. Replace distribution if necessary. Keep tank as shallow as possible to ensure fall.

INITIAL SITE SKETCH

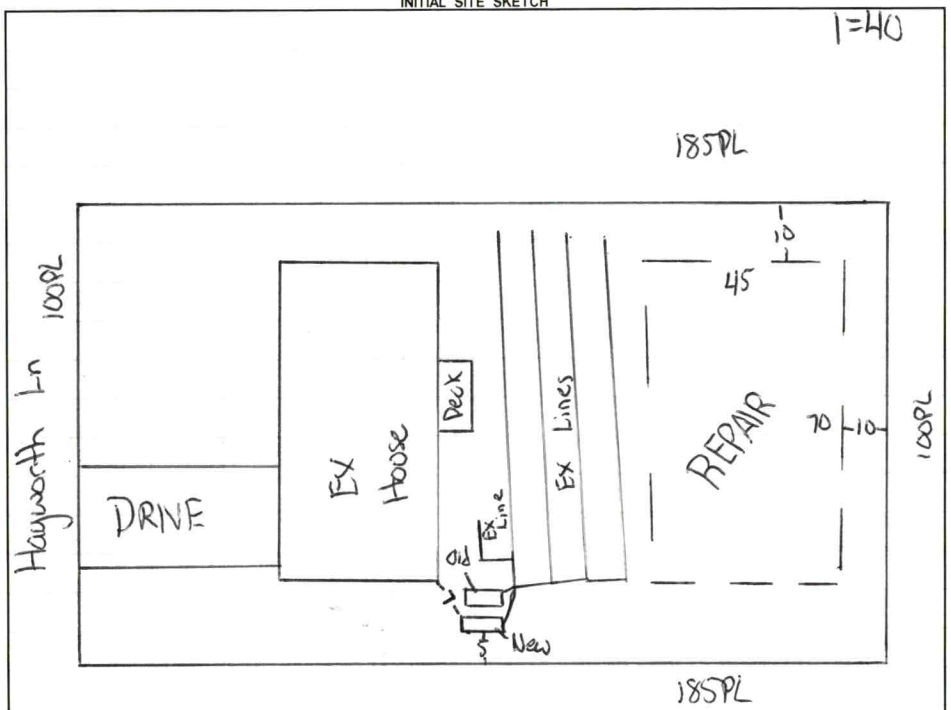

AS BUILT SKETCH

FOR SEPTIC FINAL INSPECTION CALL: 704-664-3703 between 8am-9am
the day the inspection is needed. Be sure to speak with an inspector to confirm your time.

Distribution replaced - D-Box @ start of each line - STH

Permit can be suspended or revoked if any false information is supplied toward securing the permit / any unauthorized changes are made to the site / any unauthorized changes are made in the installation of the system. **CONTACT A LOCATOR SERVICE PRIOR TO ANY EXCAVATION**

☐ **IMPROVEMENT PERMIT** ***with plat*** *valid without expiration.* ☒ **IMPROVEMENT PERMIT** ***with site plan*** *valid for 60 mos.* ☒ **AUTHORIZATION TO CONSTRUCT** *valid for period equal to IMPROVEMENT PERMIT--not to exceed 60 mo.*

Owner / Applicant Signature: Online Signature Date: Installed by: Lentz

IMPROVEMENT PERMIT by: Cary Wilt Date: 12/14/23 OPERATION PERMIT by: Sydney Howland Date: 1/19/24

AUTHORIZATION TO CONSTRUCT by: Cary Wilt Date: 12/14/23 Existing System Inspected by: Date:

FOR SEPTIC FINAL INSPECTION: CALL 704-664-3703 between 8am-9am the day the inspection is needed.

Item	Date	Initials
Drain Lines Checked		
Tanks Checked		
Pressure Manifold or Valve Box Checked		
Pressure Head Set		
Electrical Checked		
Floats Set		
Alarm Checked		
Maintenance Contract Needed? Y / N		
Comments:		

Repairs Only	
	State Code
Failing System Code	
Type of Distribution	G or P
Type of Failure/Malfunction	
Primary Cause of Failure/Malfunction	
Age of System? _____	
Initial or Repair? _____	

IREDELL COUNTY HEALTH DEPARTMENT

STATESVILLE 704-878-5305 MOORESVILLE 704-664-5281

IMPROVEMENT PERMIT / AUTHORIZATION TO CONSTRUCT / OPERATION PERMIT / EXISTING SYSTEM INSPECTION

PERMIT# 073053 PIN# 4716 73 8732 DATE 5-16-98

OWNER OR CONTRACTOR CRANDALL AND O'BRIEN PHONE: Business 871-1536 Home

ADDRESS 310 TREEBARK ROAD, STATESVILLE, NC 28625

LOCATION NC 90 WEST, TR LITTLE FARM ROAD, TL HAYWORTH DRIVE, 3RD LOT ON RIGHT

SUBDIVISION SUMMERSET BLOCK / SECTION LOT 27 LOT AREA 0.425 ACRE SITE CLASS PS DESIGN FLOW 360 L.T.A.R. 0.30 GPD/FT2

Septic Tank: 1000 Gallons; STB 1012 Date 10-19-98

Pump Tank: Gallons; PT Date

Pump Make: Model Serial No.

Nitrification Field: No Fields 1 Square Feet Eq. to 1200 Linear Feet 300+

No Lines FIVE Trench Width 36" Max Trench Bottom Depth 36"

☑ New System ☐ Repair System Type: I, II, III, IV, V, VI

System Description: CHAMBERED GRAVITY

Repair System Description: CHAMBERED, PUMP

Maintenance Agreement Required: ☐ Yes ☑ No

☑ House/Mod. Home No. Bedrooms 3

☐ Mobile Home No. Bathrooms 2

☐ Business No. Employees

☐ Other


~~Gravel~~ Depth SAND 6" ☐ Slab ☑ Crawl Space ☐ Basement w/plumbing ☐ Basement wo/plumbing

Water Supply: ☐ Individual ☑ Public ☐ Community


Comments:/Conditions: ① INSTALL SEPTIC TANK AT GRADE TO KEEP LINES AT 36" OR LESS ② SCOUR TRENCH SIDEWALLS AND APPLY A LIGHT DUSTING OF LIME PRIOR TO INSTALLING CHAMBERS.

Comments:/Conditions:

INITIAL SITE SKETCH SCALE: 1"=30'

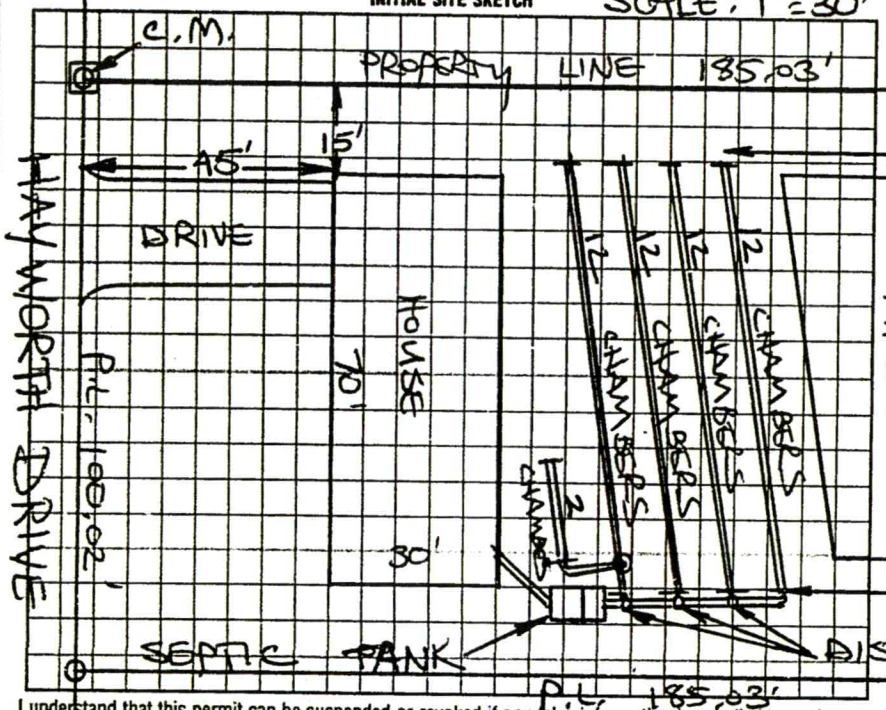

AS BUILT SKETCH

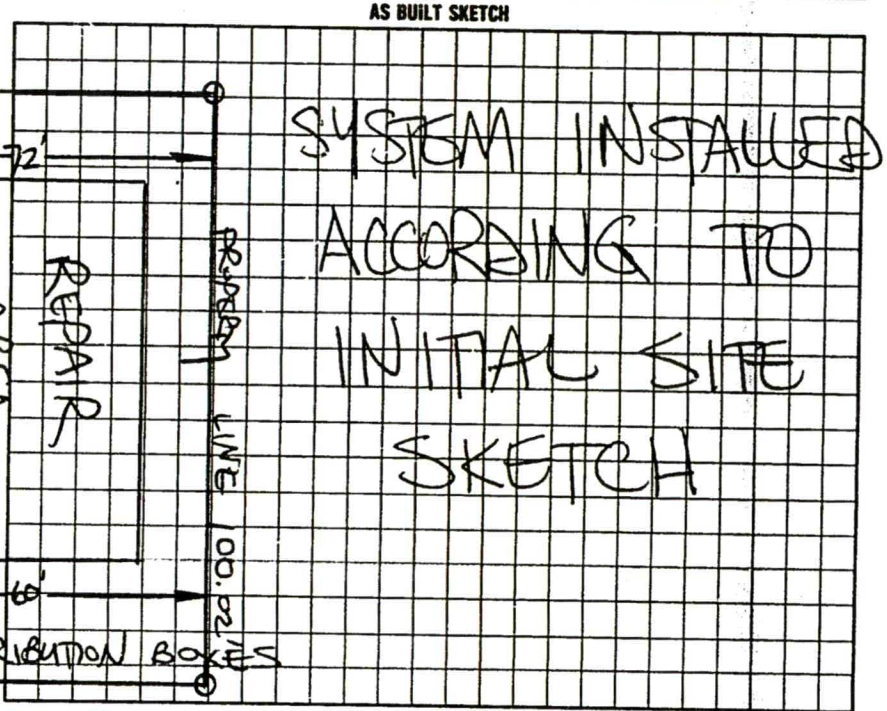

SYSTEM INSTALLED ACCORDING TO INITAL SITE SKETCH

I understand that this permit can be suspended or revoked if any false information is supplied toward securing the permit/any unauthorized changes are made to the site/any unauthorized changes are made in the installation of the system. Improvement Permit with plat valid without expiration. Improvement Permit with site plan valid for sixty months. Authorization to Construct is valid for a period equal to that of Improvement Permit – not to exceed sixty months.

Signed: date 5-20-98

Improvement Permit by: STEVE HEDRICK date 5-16-98


Authorization to Construct by: STEVE HEDRICK date 5-16-98

Installed by: A-1 BACKHOE

Operation Permit by: STEVE HEDRICK date 12-31-98

Existing System Inspection by: date

HEALTH DEPT COPY: WHITE INSPECTION COPY (FINAL) GREEN OWNER COPY (FINAL): YELLOW INSPECTION COPY (INITIAL): PINK OWNER COPY (INITIAL): GOLD

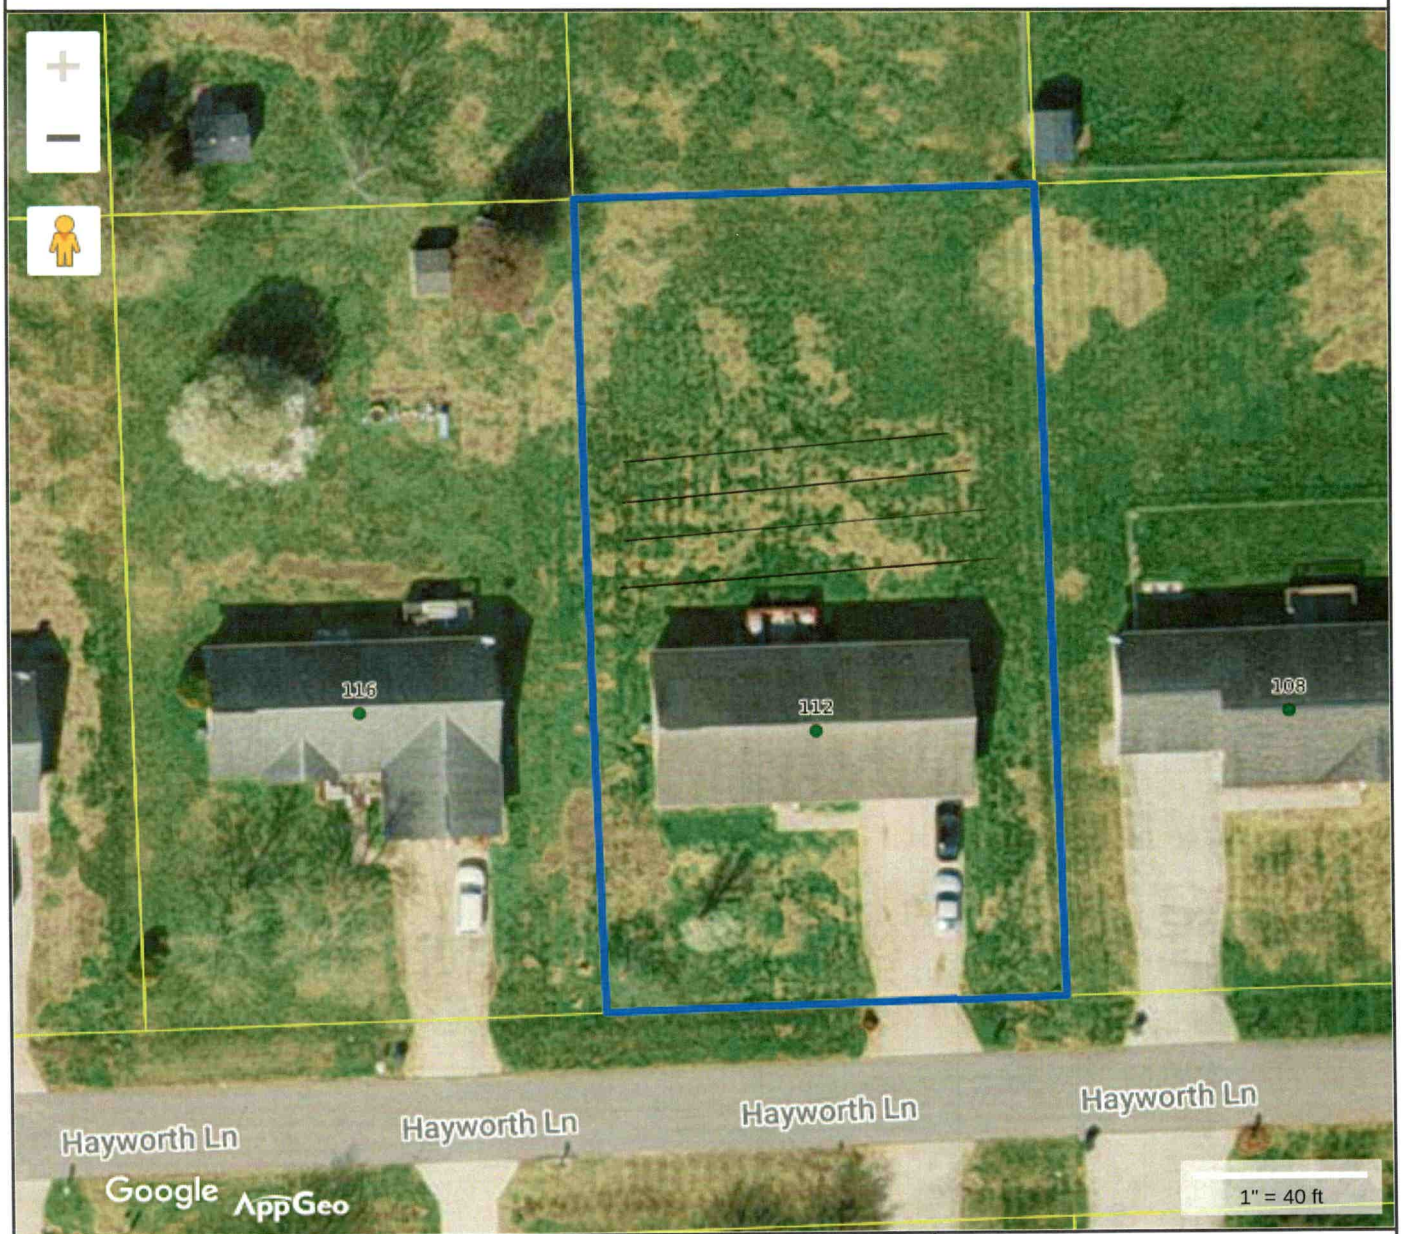

Tax Map Information

• PIN	4716738732,000
• Address	112 HAYWORTH LN
• Account #	Acct 77441497
• Tax Owner	MUNDAY CLAUDE R HEIRS
• Mailing Address	112 HAYWORTH LN
•	STATESVILLE, NC 28625
• GIS Owner	BARNETT JOHN+MONICA
• Deed Info	3029 / 1660 - WD - 20231128
• Tax Acres	0.43 AC
• Lot #	27
• Description	SUMMERSET PB29-99
• Zoning	RA
• Old Parcel #	
• Bldg Value	$202,340
• OBXF Value	$2,300
• Land Value	$30,000
• Total Value	$234,640
• Defer Value	$0
• Tax Districts	-ALLCNTY FIRE- -

IREDELL COUNTY NC

MAP FOR REFERENCE ONLY
NOT A LEGAL DOCUMENT

Iredell County, North Carolina makes no claims and no warranties, expressed or implied, concerning the validity or accuracy of the GIS data presented on this map.

Geometry updated 11/15/2023
Data updated 11/14/2023

Print map scale is approximate. Critical layout or measurement activities should not be done using this resource.