IREDELL COUNTY HEALTH DEPARTMENT

STATESVILLE 704-878-5305 MOORESVILLE 704-664-5281

IMPROVEMENT PERMIT / CERTIFICATE OF COMPLETION / OPERATION PERMIT / EXISTING SYSTEM INSPECTION

PROPERTY DESCRIPTION NO. 067685 DATE 7-12-97 TAX MAP NO. 4716737134 Watershed: ☐ Yes ☑ No

OWNER OR CONTRACTOR CRANDALL / O'BRIEN PHONE: Business _____ Home 871-1536

ADDRESS 296 TREEBARK ROAD, STATESVILLE, NC 28677

LOCATION NC 115 N TL SCOTTS CREEK, TL LITTLE FARM, TR GRANGER LANE, 2ND LOT ON LEFT

SUBDIVISION SUMMERSET BLOCK / SECTION _____ LOT 3 LOT AREA 0.425 ACRE SITE CLASS. PS DESIGN FLOW 360 L.T.A.R. 0.30 GPD/FT2

Septic Tank: 1000 Gallons; STB 1017 Date 9-21-97

Pump Tank: _____ Gallons; PT _____ Date _____

Pump Make: _____ Model _____ Serial No. _____

Nitrification Field: No Fields 1 Square Feet 1200 Linear Feet 400

No Lines FIVE Trench Width 36" Max Trench Bottom Depth 36" Gravel Depth 12"

☑ New System ☐ Repair System Type: I, II, III, IV, V, VI

System Description: CONVENTIONAL GRAVITY

Repair System Description: CONV. GRAV / PUMP

Maintenance Agreement Required: ☐ Yes ☑ No

☑ House/Mod. Home No. Bedrooms 3

☐ Mobile Home No. Bathrooms 2

☐ Business No. Employees _____

☐ Other _____


☐ Slab ☑ Crawl Space ☐ Basement w/plumbing ☐ Basement wo/plumbing

Water Supply:
☐ Individual
☐ Community
☑ Public

Comments:

Comments:

INITIAL SITE SKETCH SCALE: 1"=40'

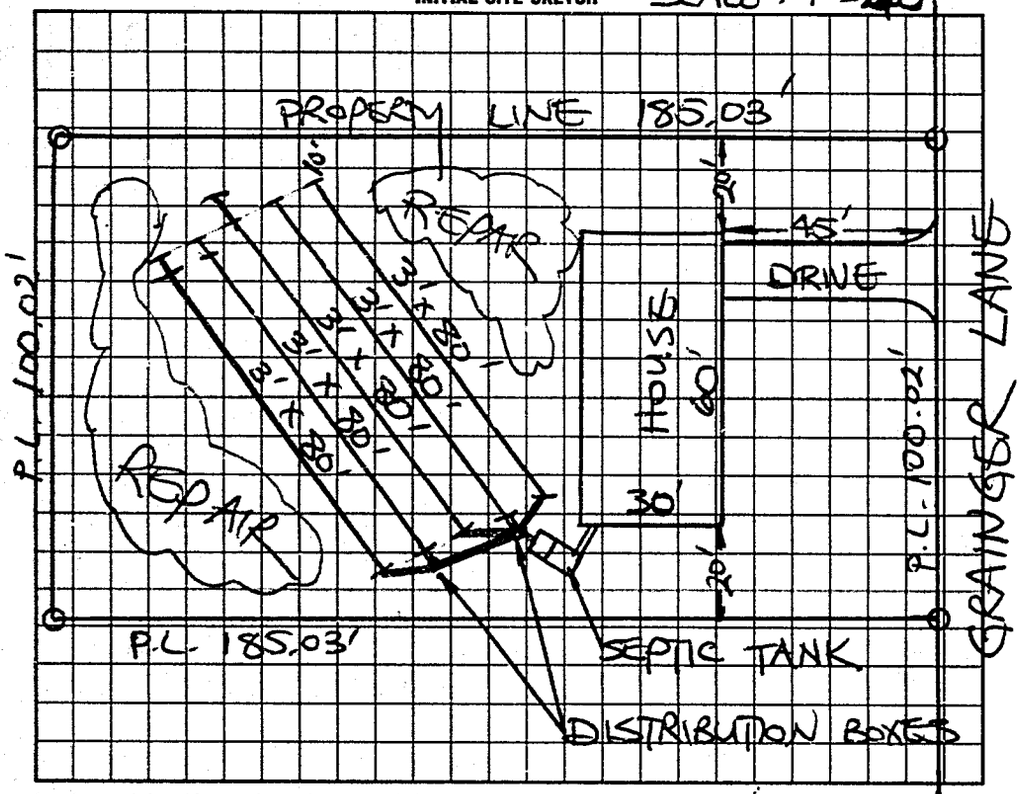

AS BUILT SKETCH

Installed as shown

I understand that this permit can be suspended or revoked if any false information is supplied toward securing the permit/any unauthorized changes are made to the site/any unauthorized changes are made in the installation of the system. Improvement Permit is valid for 60 months from date of issuance. AUTHORIZATION TO CONSTRUCT IS VALID FOR 60 MONTHS FROM DATE OF ISSUANCE.

Signed: _____

Improvement Permit by: STEVE HEDRICK date 7-12-97

AUTH. TO CONST. ~~Existing System Inspection~~ by: STEVE HEDRICK date 7-12-97

Installed by: A-1 Backhoe

~~Certificate of Completion~~ by: _____ date _____

Operation Permit by: Mary C Coffey date 1-14-98

HEALTH DEPT. COPY: WHITE INSPECTION COPY (FINAL): GREEN OWNER COPY (FINAL): YLLLOW INSPECTION COPY (INITIAL): PINK OWNER COPY (INITIAL): GOLD

259000