IREDELL COUNTY HEALTH DEPARTMENT

STATESVILLE 704-878-5305 MOORESVILLE 704-664-5281

IMPROVEMENT PERMIT / AUTHORIZATION TO CONSTRUCT / OPERATION PERMIT / EXISTING SYSTEM INSPECTION

PERMIT# REPAIR PIN# 4716-74-4130 DATE 3-14-03

OWNER OR CONTRACTOR MICHAEL W. LEWIS PHONE: Business (704) 902-3696 Home 704-924-9626

ADDRESS 128 GRANGER LANE STATESVILLE NC 28625

LOCATION NC 115 N, TR SCOTTS CREEK RD TL LITTLE FARM RD, TR GRANGER LANE LOT AT END

SUBDIVISION SUMMERSET BLOCK / SECTION _____ LOT 37 LOT AREA 0.51 ACRE SITE CLASS. PS DESIGN FLOW 360 L.T.A.R. 0.30 GPD/FT2

Septic Tank: EXISTING Gallons: STB _____ Date _____

Pump Tank: _____ Gallons: PT _____ Date _____

Pump Make: _____ Model _____ Serial No. _____

Nitrification Field: No Fields 1 Square Feet 165 Linear Feet 55

No Lines THREE Trench Width 36" Max Trench Bottom Depth _____ Gravel Depth 24"

☐ New System ☑ Repair System Type: I (II) III, IV, V, VI

System Description: _____

Repair System Description: CONVENTIONAL, GRAVITY

Maintenance Agreement Required: ☐ Yes ☒ No

☐ House/Mod. Home No. Bedrooms 3

☐ Mobile Home No. Bathrooms 2

☐ Business No. Employees _____

☐ Other _____


☐ Slab ☑ Crawl Space ☐ Basement w/plumbing ☐ Basement wo/plumbing

Water Supply: ☐ Individual ☑ Public ☐ Community


Comments:/Conditions: INSTALL NEW LINES AS FLAGGED USING STEPDOWNS ON GRADE TO KEEP SYSTEM AS SHALLOW AS POSSIBLE. USE 24" + STONE IN TRENCHES

Comments:/Conditions: THIS PERMIT SERVES AS "NOTICE OF VIOLATION" SYSTEM TO BE REPAIRED BY 4-14-2003

INITIAL SITE SKETCH

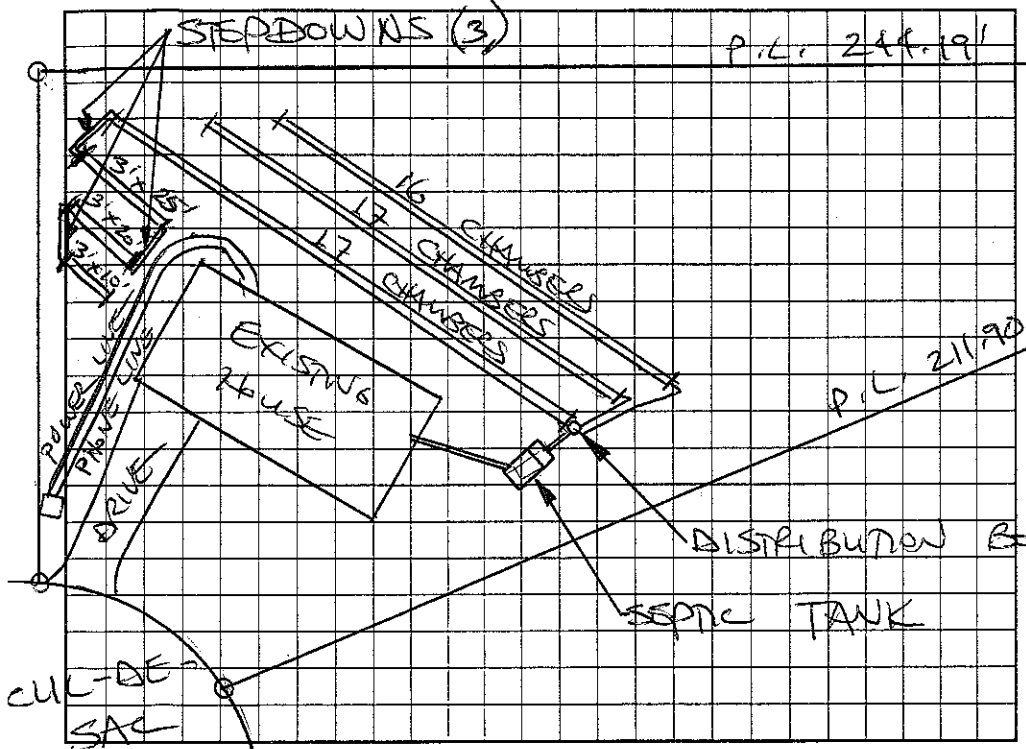

AS BUILT SKETCH

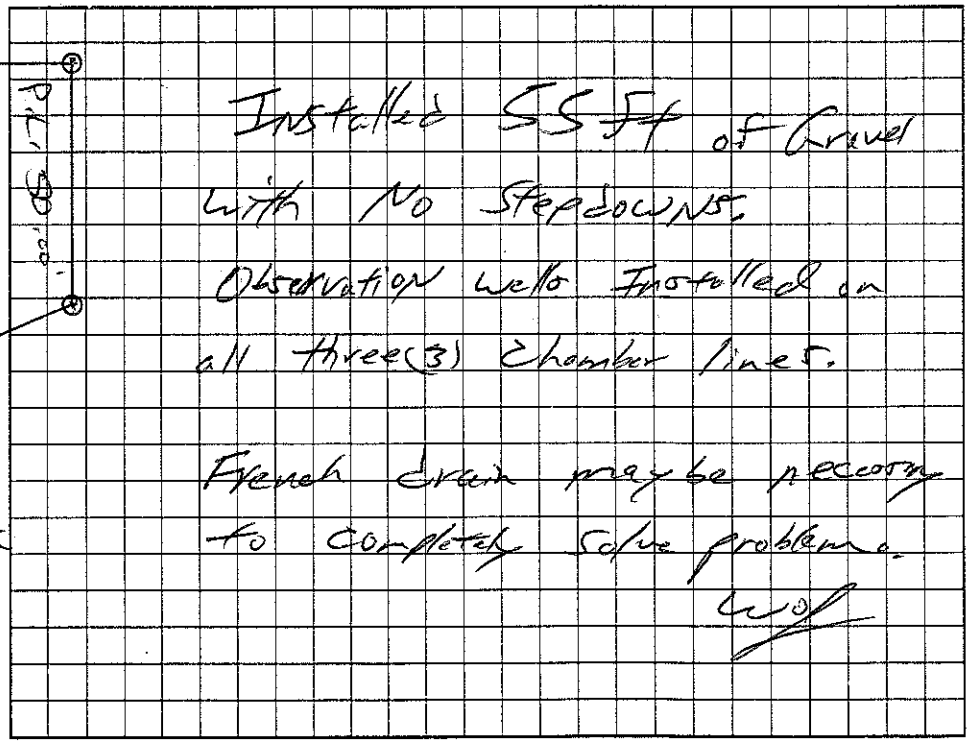

Permit can be suspended or revoked if any false information is supplied toward securing the permit/any unauthorized changes are made to the site/any unauthorized changes are made in the installation of the system. Improvement Permit with plat valid without expiration. Improvement Permit with site plan valid for sixty months. Authorization to Construct is valid for a period equal to that of Improvement Permit – not to exceed sixty months.

Signed: + Michael Lewis date 3-14-03 Installed by: Steve Jordan

Improvement Permit by: STEVE HEDRICK date 3-14-03 Operation Permit by: William O. Johnson date 4/16/03

Authorization to Construct by: STEVE HEDRICK date 3-14-03 Existing System Inspection by: _____ date _____

HEALTH DEPT. COPY: WHITE OWNER COPY (FINAL): YELLOW OWNER COPY (INITIAL): PINK