IREDELL COUNTY HEALTH DEPARTMENT

STATESVILLE 704-878-5305 MOORESVILLE 704-664-5281

IMPROVEMENT PERMIT / CERTIFICATE OF COMPLETION / OPERATION PERMIT / EXISTING SYSTEM INSPECTION

PROPERTY DESCRIPTION NO. 067689 DATE 7-12-97 TAX MAP NO. 4716737134 Watershed: ☐ Yes ☒ No

OWNER OR CONTRACTOR CRANDALL / O'BRIEN PHONE: Business 871-1536 Home

ADDRESS 296 TREEBARK ROAD STATESVILLE, NC 28677

LOCATION NC 115 N TL SCOTTS CREEK, TL LITTLE FARM, TR GRAINGER LANES, 6TH LOT ON RIGHT

SUBDIVISION SUMMERSET BLOCK / SECTION LOT 38 LOT AREA 0.51 ACRE SITE CLASS. PS DESIGN FLOW 360 L.T.A.R. 0.30 GPD/FT²

Septic Tank: 1000 Gallons; STB 1012 Date 6-19-98

Pump Tank: Gallons; PT Date

Pump Make: Model Serial No.

Nitrification Field: No Fields 1 Square Feet REQ. 1200 Linear Feet 312'

No Lines FOUR Trench Width 36" Max Trench Bottom Depth 36" Gravel Depth NA"

☒ New System ☐ Repair System Type: I, II, III, IV, V

System Description: CHAMBERED GRAVITY

Repair System Description: CHAMBERED PUMP

Maintenance Agreement Required: ☐ Yes ☒ No

☐ House/Mod. Home No. Bedrooms 3

☐ Mobile Home No. Bathrooms 2

☐ Business No. Employees

☒ Other


☐ Slab ☒ Crawl Space ☐ Basement w/plumbing ☐ Basement wo/plumbing

Water Supply: ☐ Individual ☐ Community ☒ Public


Comments: INSTALL 52 CHAMBERS IN FOUR EQUAL LENGTH LINES ON CONTOUR AS SHOWN

Comments: Note: Tank closer to back corner

INITIAL SITE SKETCH SCALE: 1" = 40'

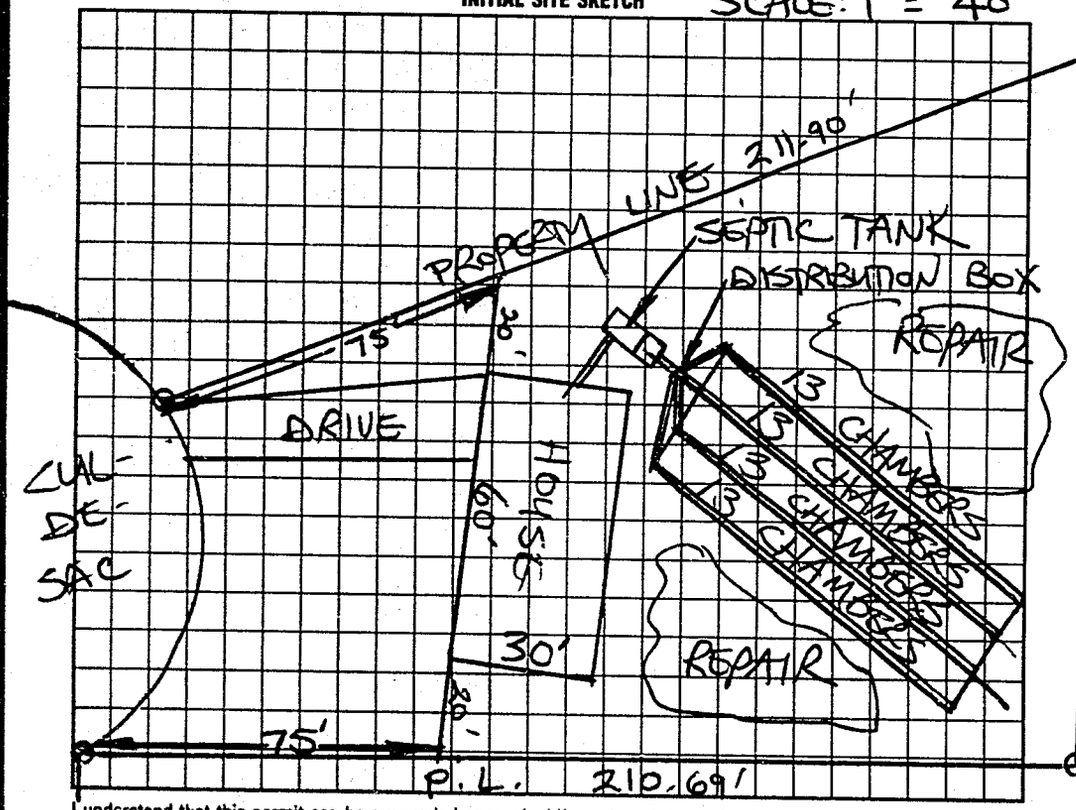

AS BUILT SKETCH

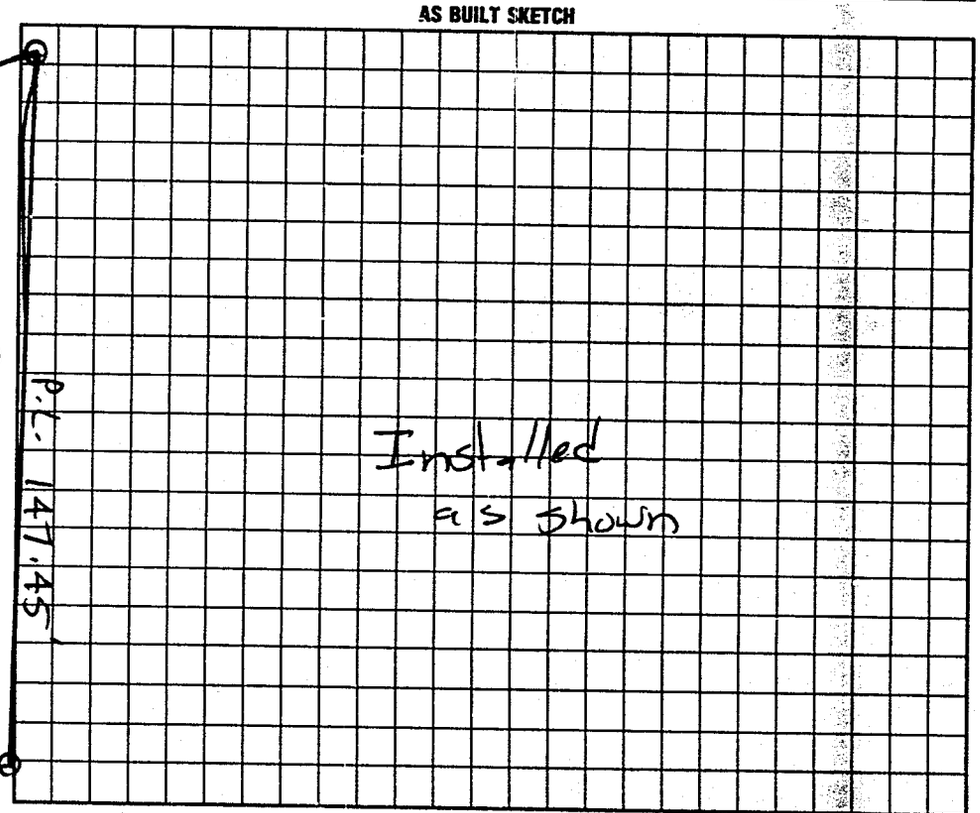

I understand that this permit can be suspended or revoked if any false information is supplied toward securing the permit/any unauthorized changes are made to the site/any unauthorized changes are made in the installation of the system. Improvement Permit is valid for 60 months from date of issuance. AUTHORIZATION TO CONSTRUCT IS VALID FOR 60 MONTHS FROM DATE OF ISSUANCE.

Signed:

Improvement Permit by: STEVE HEDRICK date 7-12-97

AUTH. TO CONST.

~~Existing System Inspection~~ by: STEVE HEDRICK date 7-12-97

Installed by: A-1

~~Certificate of Completion by:~~ date

Operation Permit by: M.C. Off RS date 3-10-98

HEALTH DEPT. COPY: WHITE INSPECTION COPY (FINAL): GREEN OWNER COPY (FINAL): YELLOW INSPECTION COPY (INITIAL): PINK OWNER COPY (INITIAL): GOLD