pd'd 25 1-1398

IREDELL COUNTY HEALTH DEPARTMENT

STATESVILLE 704-878-5305 MOORESVILLE 704-664-5281

IMPROVEMENT PERMIT / AUTHORIZATION TO CONSTRUCT / OPERATION PERMIT / EXISTING SYSTEM INSPECTION

PERMIT# 070963 PIN# 4716737134 DATE Jan. 8, '98

OWNER OR CONTRACTOR Crandall & O'Brien PHONE: Business 871-1536 Home

ADDRESS 279 Treebark Rd. Statesville 28677

LOCATION 115 N. TR Scotts Creek Rd. TL Little Farm Rd. TR Grainger Ln. on Right

SUBDIVISION Summerset BLOCK / SECTION 1 LOT 39 LOT AREA .48 Ac SITE CLASS. PS DESIGN FLOW 360 gpd. L.T.A.R. .3

Septic Tank: 1000 Gallons; STB 1012 Date 3-1-98

Pump Tank: Gallons; PT Date

Pump Make: Model Serial No.

Nitrification Field: No Fields 1 Square Feet 900 Linear Feet 300

No Lines 4@75' Trench Width 36" Max Trench Bottom Depth 36" Gravel Depth N/A

☑ New System ☐ Repair System Type: I, II, III, IV, V, VI

System Description: Gravity Modified 25% Reduction

Repair System Description: Grav/pumped conv/modified

Maintenance Agreement Required: ☐ Yes ☑ No

☑ House/Mod. Home No. Bedrooms 3

☐ Mobile Home No. Bathrooms 2

☐ Business No. Employees

☐ Other

☐ Slab ☑ Crawl Space ☐ Basement w/plumbing ☐ Basement wo/plumbing


Water Supply: ☐ Individual ☑ Public ☐ Community

Comments:/Conditions: * ONE inspection/observation port per lateral Contact Health Dept. if questions exist regarding types of modified 25% Reduction Systems. Install Stormwater Diversion Ditch Along side & Rear property lines.

Comments:/Conditions: Inspection of Landscaping to Come later Ditch installed - 5/28 MD

1" = 50'

INITIAL SITE SKETCH

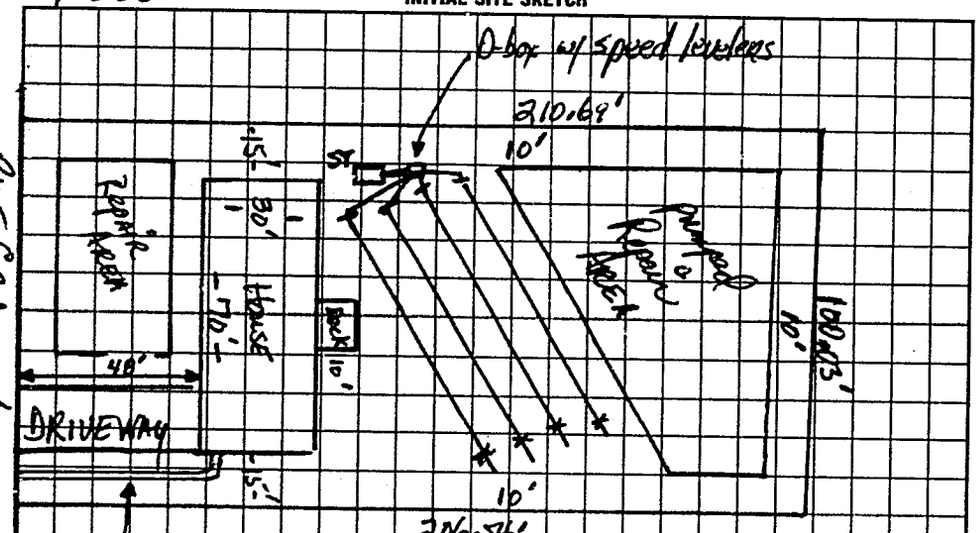

AS BUILT SKETCH

Same as initial sketch

I understand that this permit can be suspended or revoked if any false information is supplied toward securing the permit/any unauthorized changes are made to the site/any unauthorized changes are made in the installation of the system. Improvement Permit with plat valid without expiration. Improvement Permit with site plan valid for sixty months. Authorization to Construct is valid for a period equal to that of Improvement Permit – not to exceed sixty months.

Signed: * date

Improvement Permit by: date 1-8-98

Authorization to Construct by: date 1-8-98

Installed by: A-1 Backhoe

Operation Permit by: J.C. Moore date 5-5-98

Existing System Inspection by: date

HEALTH DEPT. COPY: WHITE INSPECTION COPY (FINAL): GREEN OWNER COPY (FINAL): YELLOW INSPECTION COPY (INITIAL): PINK OWNER COPY (INITIAL): GOLD