cd725 1413 93

IREDELL COUNTY HEALTH DEPARTMENT

STATESVILLE 704-878-5305 MOORESVILLE 704-664-5281

IMPROVEMENT PERMIT / AUTHORIZATION TO CONSTRUCT / OPERATION PERMIT / EXISTING SYSTEM INSPECTION

PERMIT# 070964 PIN# 4716737134 DATE Jan. 8, '98

OWNER OR CONTRACTOR Crandall & O'Brien Const. PHONE: Business 871-1536 Home

ADDRESS 279 TREEBARK Rd. Statesville

LOCATION 115 N. TL Scotts Creek Rd. TL Little Fork Rd. TR GRAINGER LN. ON Right

SUBDIVISION Summerset BLOCK / SECTION 1 LOT 40 LOT AREA .47Ac SITE CLASS. PS DESIGN FLOW 360gpd L.T.A.R. .225

Septic Tank: 1000 Gallons; STB Date

Pump Tank: Gallons; PT Date

Pump Make: Model Serial No.

Nitrification Field: No Fields 1 Square Feet 1080 Linear Feet 360

No Lines 4@90' Trench Width 36" Max Trench Bottom Depth ~32" Gravel Depth NA

☑ New System ☐ Repair System Type: I II III IV V VI

System Description: Gravity Modified 25% Reduction

Repair System Description: gravity/pumped modified

Maintenance Agreement Required: ☐ Yes ☑ No

☑ House/Mod. Home No. Bedrooms 3

☐ Mobile Home No. Bathrooms 2

☐ Business No. Employees


☐ Other

☐ Slab ☑ Crawl Space ☐ Basement w/plumbing ☐ Basement wo/plumbing

Water Supply: ☐ Individual ☑ Public ☐ Community


Comments:/Conditions: * ONE inspection/observation port per Lateral Install STORMWATER DIVERSION ditch ALONG REAR & side PROPERTY LINES. Contact Health Dept. if questions exist regarding types of modified 25% Reduction systems.

INITIAL SITE SKETCH

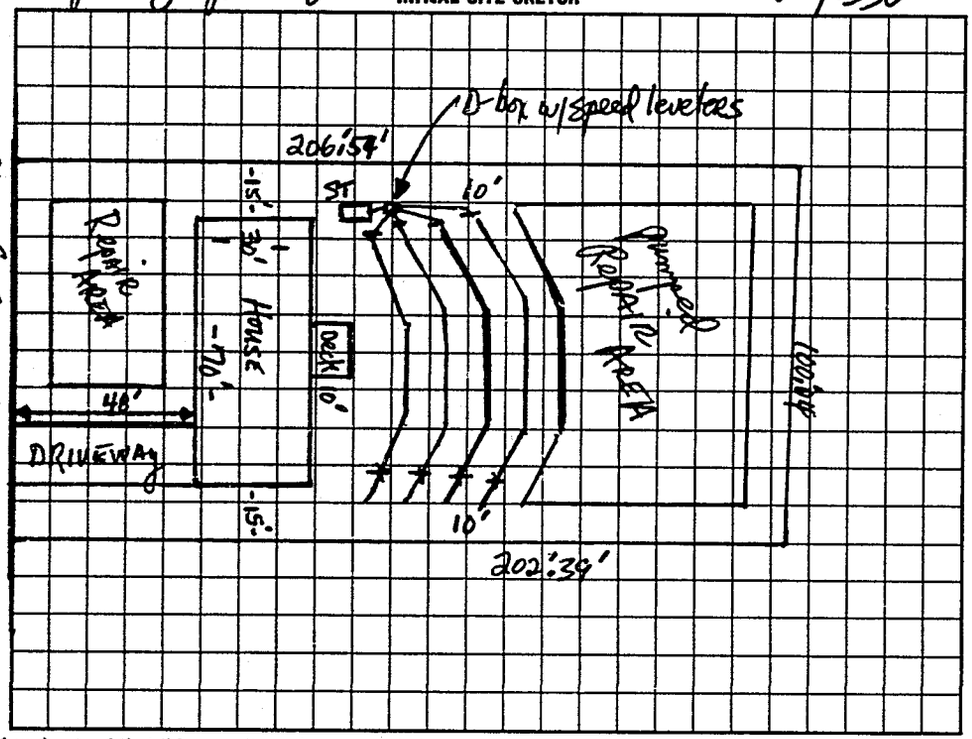

Comments:/Conditions: Inspection of Landscaping to come later inspected Ditch installed 5/28 JWO

AS BUILT SKETCH

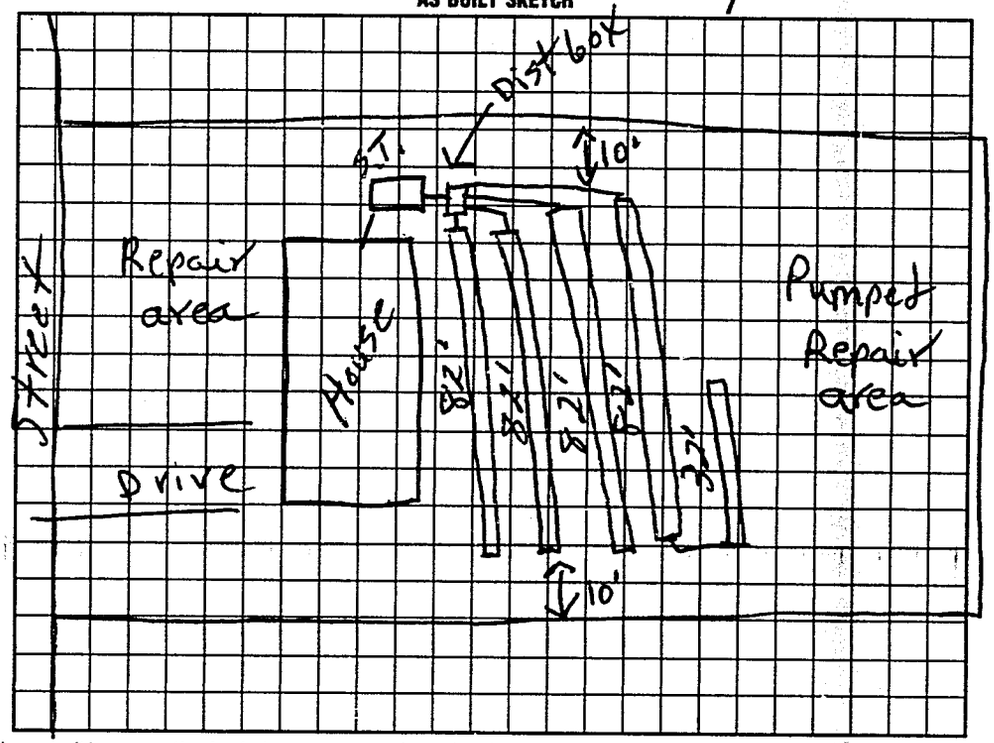

I understand that this permit can be suspended or revoked if any false information is supplied toward securing the permit/any unauthorized changes are made to the site/any unauthorized changes are made in the installation of the system. Improvement Permit with plat valid without expiration. Improvement Permit with site plan valid for sixty months. Authorization to Construct is valid for a period equal to that of Improvement Permit – not to exceed sixty months.

Signed: * date

Improvement Permit by: David R. Thumm, RS date 1-8-98

Authorization to Construct by: David R. Thumm, RS date 1-8-98

Installed by: A-1 Backhoe

Operation Permit by: B. C. Moore date 5-5-98

Existing System Inspection by: date

HEALTH DEPT. COPY WHITE INSPECTION COPY (FINAL) GREEN OWNER COPY (FINAL) YELLOW INSPECTION COPY (INITIAL) PINK OWNER COPY (INITIAL) GOLD

R/W Grainger Lane

6 6 9 0 0