IREDELL COUNTY HEALTH DEPARTMENT

Statesville Office (704) 878-5305 Mooresville Office (704) 660-3625 PERMIT # 179629

IMPROVEMENT PERMIT / AUTHORIZATION TO CONSTRUCT / OPERATION PERMIT / EXISTING SYSTEM

PIN # 4716787400

APPLICANT: Danny M Lippard Construction APPLICANT ADDRESS: PO Box 629

SITE ADDRESS: 1254 ~~Hatton~~ Hallmark Rd PHONE: 704-871-1800 ALT. PHONE:

SITE DIRECTIONS: 115 N, Left Midway, Left on Hall


SUBDIVISION: n/a SECTION: n/a LOT # n/a LOT AREA: 87.83 DESIGN FLOW: 360 L.T.A.R.: .3

Septic Tank	1000 (gal)	STB	1012	Date	2-13-14	☒ New System	☐ Repair	☐ Expansion	System Type: I II (III) IV V VI	☒ Residence	No. Bedrooms 3
Pump Tank	N/A (gal)	PT	W/A	Date	N/A	System Description:	25% Reduction - Gravity			☐ Business	No. Persons
Pump Make	N/A	Model	Tuftite	Serial #	EF4	Repair System Description:	25% Reduction - Gravity			☐ Other	No. Employees
# Nitrification Fields	1	# Lines	3	Linear Ft:	300	Maintenance Agreement Required:	☐ YES	☒ NO		☐ Slab	☒ Crawl Space
Trench Width	36"	Max. Trench Bottom Depth	36"	Gravel Depth	n/a		☒ GRAVITY	☐ PRESSURE		☐ Basement w/plumbing	☐ Basement w/o plumbing

Water Supply: ☒ Private ☐ Public ☐ Community

Comments / Conditions: N-1 end of Hallmark.

INITIAL SITE SKETCH

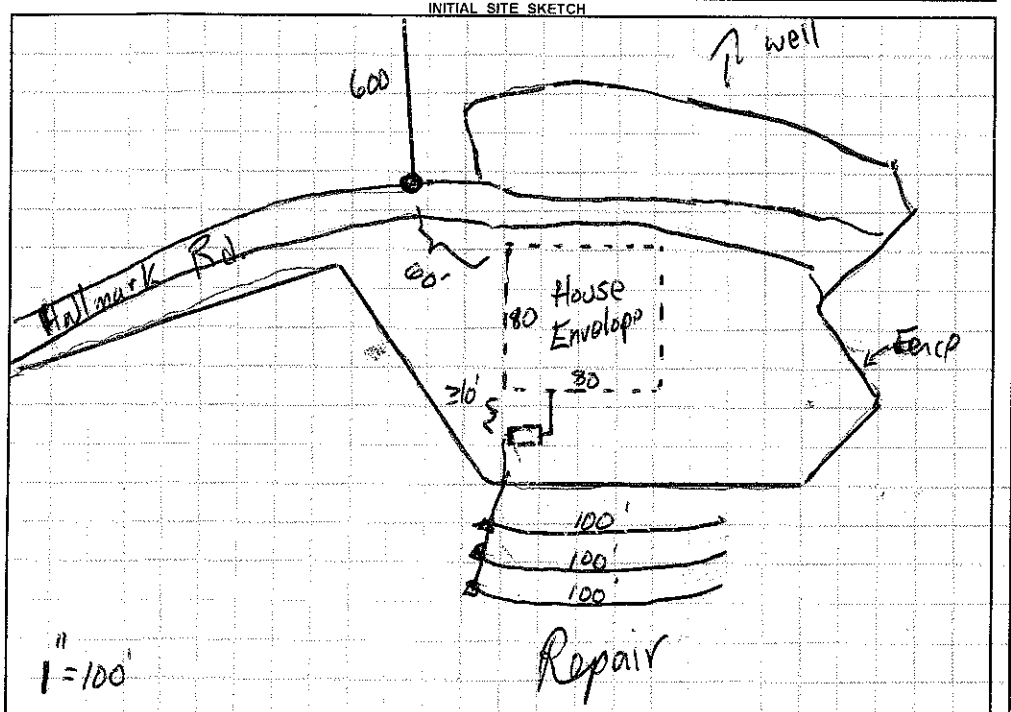

AS BUILT SKETCH

Installed Quiky as drawn

Permit can be suspended or revoked if any false information is supplied toward securing the permit / any unauthorized changes are made to the site / any unauthorized changes are made in the installation of the system. **CONTACT A LOCATOR SERVICE PRIOR TO ANY EXCAVATION**

☐ **IMPROVEMENT PERMIT** *with plat valid without expiration* ☒ **IMPROVEMENT PERMIT** *with site plan valid for 60 mos.* ☒ **AUTHORIZATION TO CONSTRUCT** *valid for period equal to IMPROVEMENT PERMIT--not to exceed 60 mo.*

Owner / Applicant Signature: _____ Date: _____ Installed by: Yountz Septic

IMPROVEMENT PERMIT by: _____ Date: 9-13-13 OPERATION PERMIT by: _____ Date: 05/29/14

AUTHORIZATION TO CONSTRUCT by: _____ Date: 9-16-13 Existing System Inspected by: _____ Date: _____

Health Dept. Copy - WHITE Applicant (Final Approval) - YELLOW Applicant (Conditional Approval) - PINK