IREDELL COUNTY HEALTH DEPARTMENT

STATESVILLE 704-878-5305 MOORESVILLE 704-664-5281

65830

IMPROVEMENT PERMIT / CERTIFICATE OF COMPLETION / OPERATION PERMIT / EXISTING SYSTEM INSPECTION

PROPERTY DESCRIPTION NO. 25652 DATE 3-24-97 TAX MAP NO. 90-9-A-68A Watershed: ☐ Yes ☐ No

OWNER OR CONTRACTOR Joseph P. Clendenin PHONE: Business _____ Home _____

ADDRESS 282 Little Farm Rd

LOCATION 90 W TR Little Farm Rd 1/2mi Rt.

SUBDIVISION _____ BLOCK / SECTION _____ LOT _____ LOT AREA 1.1 acres SITE CLASS. PS DESIGN FLOW 360 L.T.A.R. 1.3

Septic Tank: 1000 Gallons; STB 821 Date 3-14-97

Pump Tank: _____ Gallons; PT _____ Date _____

Pump Make: _____ Model _____ Serial No. _____

Nitrification Field: No Fields 1 Square Feet 1200 Linear Feet 400

No Lines 4 Trench Width 36" Max Trench Bottom Depth 36" Gravel Depth 12"

☑ New System ☐ Repair System Type: I, II, III, IV, V, VI

System Description: Conv. Gravity

Repair System Description: " "

Maintenance Agreement Required: ☐ Yes ☐ No

☐ House/Mod. Home No. Bedrooms 3

☑ Mobile Home No. Bathrooms 2

☐ Business No. Employees ____

☐ Other _____


☐ Slab ☑ Crawl Space ☐ Basement w/plumbing ☐ Basement wo/plumbing

Water Supply: ☐ Individual ☐ Community ☑ Public


Comments:

Comments:

INITIAL SITE SKETCH

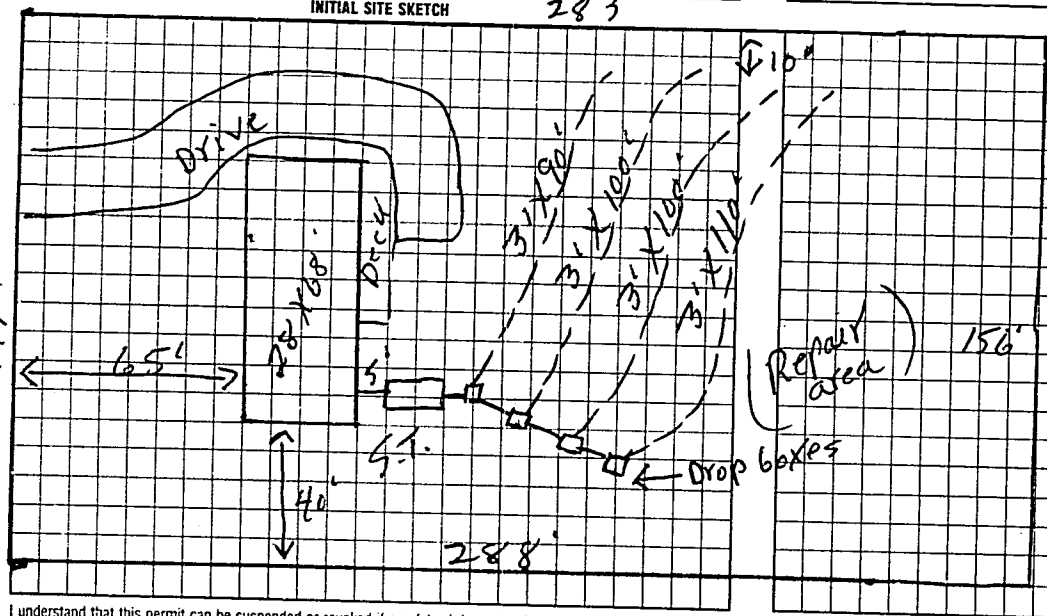

AS BUILT SKETCH

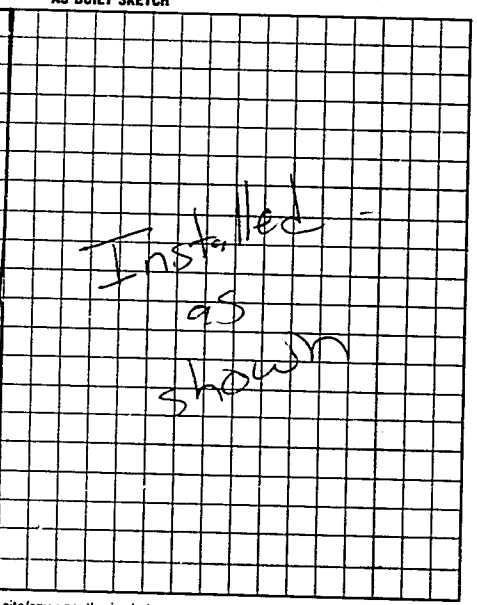

I understand that this permit can be suspended or revoked if any false information is supplied toward securing the permit/any unauthorized changes are made to the site/any unauthorized changes are made in the installation of the system. Improvement Permit is valid for 60 months from date of issuance.

Signed: X Joseph Patrick Clendenin

Improvement Permit by: L. C. Moore date 3-24-97

~~Authorization~~ Existing System Inspection by L. C. Moore date 3-24-97

to count. authorization to count. expires 60 mos from issue

Installed by: Ray Ward

Certificate of Completion by: _____ date _____

Operation Permit by: Mary C Ogburn date 4-15-97

HEALTH DEPT. COPY: WHITE INSPECTION COPY (FINAL): GREEN OWNER COPY (FINAL): YELLOW INSPECTION COPY (INITIAL): PINK OWNER COPY (INITIAL): GOLD