IREDELL COUNTY HEALTH DEPARTMENT

STATESVILLE 704-878-5305 MOORESVILLE 704-664-5281

IMPROVEMENT PERMIT / CERTIFICATE OF COMPLETION / OPERATION PERMIT / EXISTING SYSTEM INSPECTION

PROPERTY DESCRIPTION NO. 067684 DATE 7-12-97 TAX MAP NO. 4716 73 7134 Watershed: ☐ Yes ☒ No

OWNER OR CONTRACTOR CRANDALL / O'BRIEN PHONE: Business Home 871-1536

ADDRESS 296 TREEBARK ROAD, STATESVILLE, NC 28677

LOCATION NC 115 N TL SCOTTS CREEK TL LITTLE FARM, TR GRAINGER LANE, 1ST LOT ON LEFT

SUBDIVISION SUMMERSET BLOCK / SECTION LOT 30 LOT AREA 0.51 ACRE SITE CLASS PS DESIGN FLOW 360 L.T.A.R. 0.30 GD/FT²

Septic Tank: 1000 Gallons; STB 1012 Date 9-21-97

Pump Tank: Gallons; PT Date

Pump Make: Model Serial No.

Nitrification Field: No Fields 1 Square Feet 1200 Linear Feet 400

No Lines FOUR Trench Width 36" Max Trench Bottom Depth 36" Gravel Depth 12"

☑ New System ☐ Repair System Type: I, II, III, IV, V, VI

System Description: CONVENTIONAL GRAVITY

Repair System Description: CONV. GRAV/PUMP

Maintenance Agreement Required: ☐ Yes ☒ No

☑ House/Mod. Home ☒ Mobile Home ☐ Business ☐ Other

No. Bedrooms 3 No. Bathrooms 2 No. Employees


☐ Slab ☑ Crawl Space ☐ Basement w/plumbing ☐ Basement wo/plumbing

Water Supply: ☐ Individual ☐ Community ☒ Public


Comments:

Comments:

INITIAL SITE SKETCH SCALE: 1"=40'

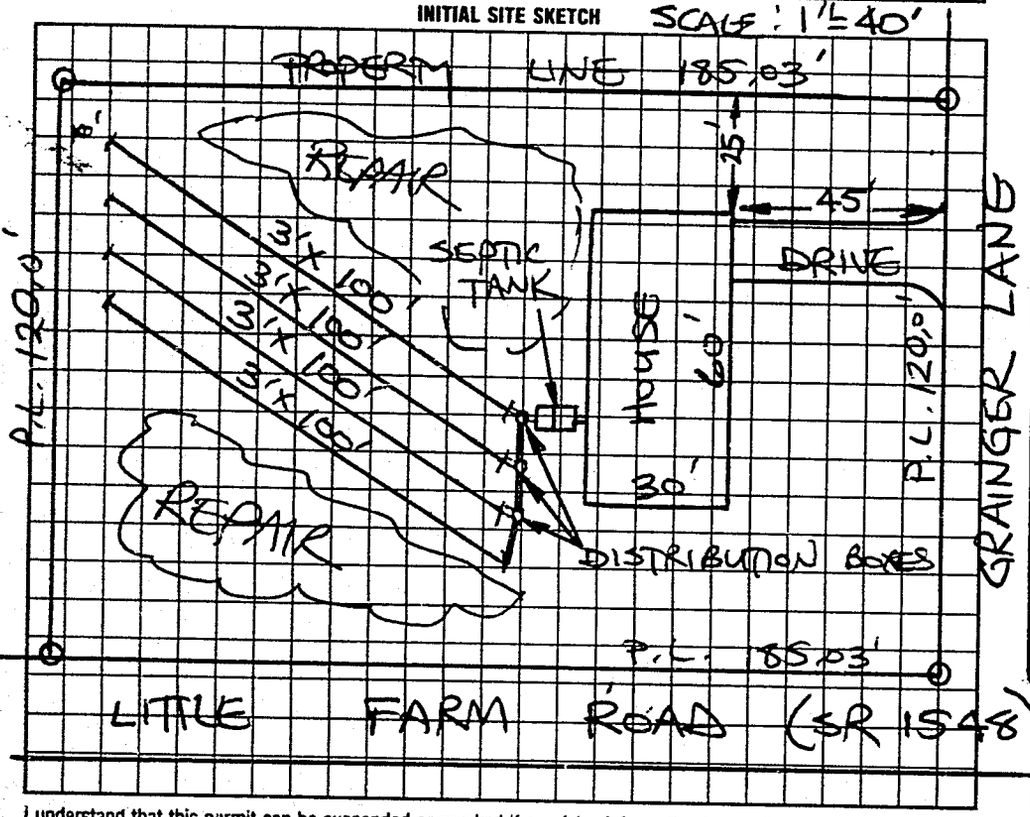

AS BUILT SKETCH

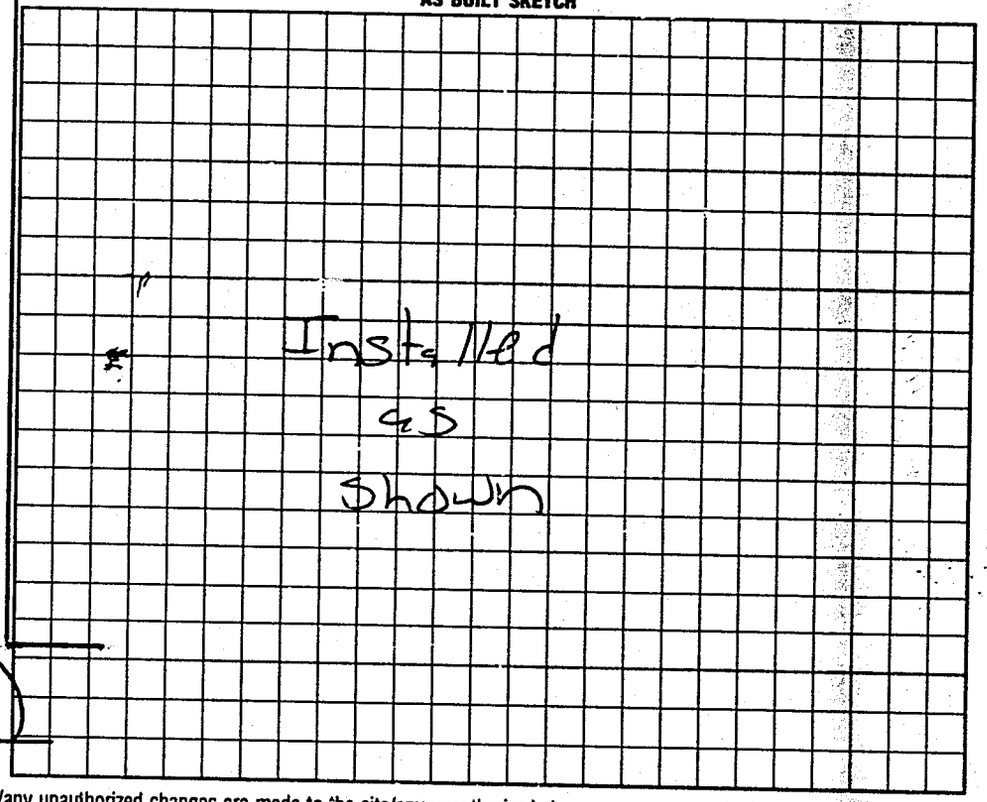

I understand that this permit can be suspended or revoked if any false information is supplied toward securing the permit/any unauthorized changes are made to the site/any unauthorized changes are made in the installation of the system. Improvement Permit is valid for 60 months from date of issuance. AUTHORIZATION TO CONSTRUCT IS VALID FOR 60 MONTHS FROM DATE OF ISSUANCE.

Signed:

Improvement Permit by: STEVE HEDRICK date 7-12-97

AUTH. TO CONST. Existing System Inspection by: STEVE HEDRICK date 7-12-97

Installed by: AT

Certificate of Completion by: date

Operation Permit by: Mark Conts RS date 6-14-98

HEALTH DEPT. COPY: WHITE INSPECTION COPY (FINAL): GREEN OWNER COPY (FINAL): YELLOW INSPECTION COPY (INITIAL): PINK OWNER COPY (INITIAL): GOLD