This Void Permit issued on 5.17.99

...ELL COUNTY HEALTH DEPARTMENT

STATESVILLE 704-878-5305 MOORESVILLE 704-664-5281

IMPROVEMENT PERMIT / AUTHORIZATION TO CONSTRUCT / OPERATION PERMIT / EXISTING SYSTEM INSPECTION

PERMIT# 8001 PIN# 4716981424 DATE July 29, 99

OWNER OR CONTRACTOR Donald Archer PHONE: Business 872-3444 Home

ADDRESS Rt 2 Box 150 Purlear NC 28135

LOCATION Hwy 115 N @ midway @ Hallmark To end of drive on left by black building Home Site in Field on Left

SUBDIVISION BLOCK / SECTION LOT LOT AREA 40 Ac SITE CLASS. PS DESIGN FLOW 375 360 L.T.A.R. 63

Septic Tank: 1000 Gallons; STB 160 Date 8 24 99
Pump Tank: Gallons; PT Date
Pump Make: Model Serial No.
Nitrification Field: No Fields 1 Square Feet 1200 Linear Feet 400
No Lines 4 Trench Width 36" Max Trench Bottom Depth 36" Gravel Depth 12"

☒ New System ☐ Repair System Type: I. II. III. IV. V. VI
System Description: Conv Gravity
Repair System Description: Sand
Maintenance Agreement Required: ☐ Yes ☒ No
☐ Slab ☒ Crawl Space ☐ Basement w/plumbing ☐ Basement wo/plumbing


☒ House/Mod. Home No. Bedrooms 3
☐ Mobile Home No. Bathrooms 2
☐ Business No. Employees
☐ Other

Water Supply: ☒ Individual ☐ Public ☐ Community WELL

Comments/Conditions: Install Lines on Contour
Start II Line & Set Tank min. Set back From Deck

Comments/Conditions:

INITIAL SITE SKETCH

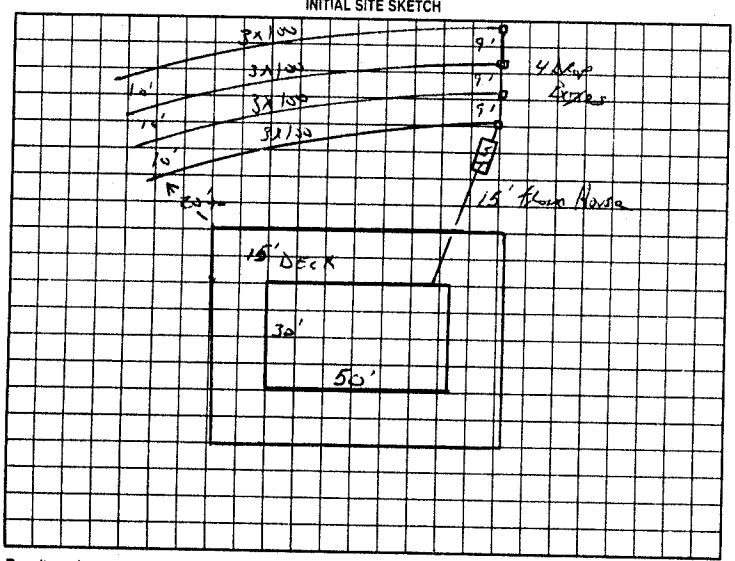

AS BUILT SKETCH

Permit can be suspended or revoked if any false information is supplied toward securing the permit/any unauthorized changes are made to the site/any unauthorized changes are made in the installation of the system. Improvement Permit with plat valid without expiration. Improvement Permit with site plan valid for sixty months. Authorization to Construct is valid for a period equal to that of Improvement Permit – not to exceed sixty months.

Signed: date 8-5-99 Installed by: Ward Grading

Improvement Permit by: date 7.29.99 Operation Permit by: date Sept 24, 99

Authorization to Construct by: date 7 29 99 Existing System Inspection by: date

HEALTH DEPT COPY: WHITE OWNER COPY (FINAL): YELLOW OWNER COPY (INITIAL): PINK