IREDELL COUNTY HEALTH DEPARTMENT

STATESVILLE 704-878-5305 MOORESVILLE 704-664-5281

IMPROVEMENT PERMIT / AUTHORIZATION TO CONSTRUCT / OPERATION PERMIT / EXISTING SYSTEM INSPECTION

PERMIT# 071035 PIN# 4717137410 (PART) DATE 12-31-97

OWNER OR CONTRACTOR DAWN L. GRYDER PHONE: Business Home 872-7767

ADDRESS 168 KISER LANE, STATESVILLE, NC 28677

LOCATION NC 115 N, TL MIDWAY ROAD, TR BAUER DRIVE, 800 FEET ON LEFT

SUBDIVISION HONEY BAUER BLOCK / SECTION LOT 22-25, PT 24 LOT AREA 4.0 ACRES SITE CLASS PS DESIGN FLOW 360 L.T.A.R. 0.30 GPD/FT²

Septic Tank: 1000 Gallons; STB 1011 Date 6-2-99
Pump Tank: Gallons; PT Date
Pump Make: Model Serial No.
Nitrification Field: No Fields 1 Square Feet 1200 Linear Feet 400
No Lines THREE Trench Width 36" Max Trench Bottom Depth 36" Gravel Depth 12"

[X] New System [ ] Repair System Type: [ ] I [ ] II [ ] III [ ] IV [ ] V [ ] VI
System Description: CONVENTIONAL GRAVITY
Repair System Description: CONV. GRAVITY
Maintenance Agreement Required: [ ] Yes [X] No
[ ] Slab [ ] Crawl Space [X] Basement w/plumbing [ ] Basement wo/plumbing


[X] House/Mod. Home No. Bedrooms 3
[ ] Mobile Home No. Bathrooms 2
[ ] Business No. Employees
[ ] Other

Water Supply: [X] Individual [ ] Public [ ] Community
WELL


Comments:/Conditions: ① KEEP SYSTEM MINIMUM 100' FROM WELL
② INSTALL LINES ON CONTOUR, AS FLAGGED

Comments:/Conditions:
Drainlines checked - upper two lines NO Deeper than 36 in soils examined Below trench bottom

INITIAL SITE SKETCH SCALE: 1"=60'

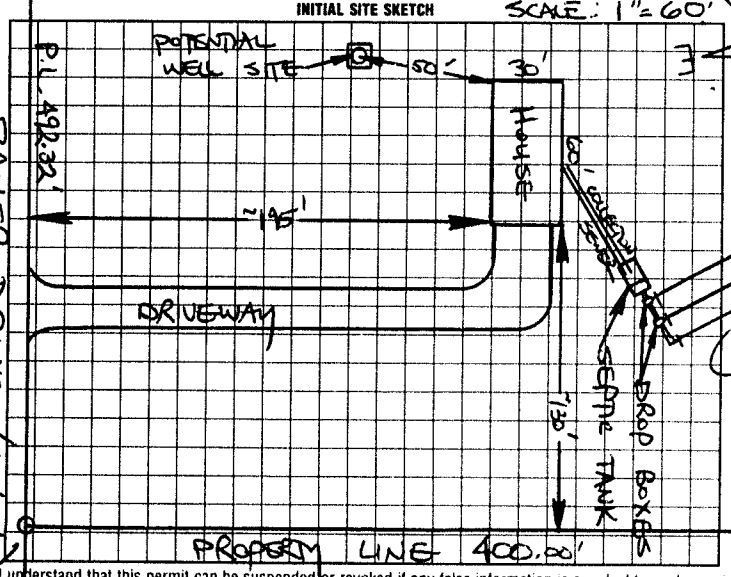

AS BUILT SKETCH

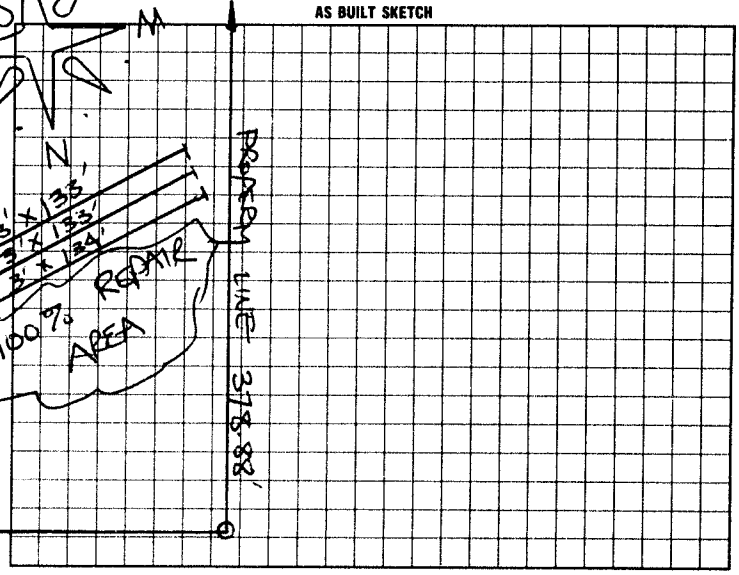

I understand that this permit can be suspended or revoked if any false information is supplied toward securing the permit/any unauthorized changes are made to the site/any unauthorized changes are made in the installation of the system. Improvement Permit with plat valid without expiration. Improvement Permit with site plan valid for sixty months. Authorization to Construct is valid for a period equal to that of Improvement Permit – not to exceed sixty months.

Signed: _____ date _____

Improvement Permit by: STEVE HEDRICK date 12-31-97

Authorization to Construct by: STEVE HEDRICK date 12-31-97

Installed by: SCOT LACKEY (HOMEOWNER)

Operation Permit by: STEVE HEDRICK date 4-11-00

Existing System Inspection by: _____ date _____

HEALTH DEPT. COPY: WHITE INSPECTION COPY (FINAL): GREEN OWNER COPY (FINAL) YELLOW INSPECTION COPY (INITIAL): PINK OWNER COPY (INITIAL): GOLD