IREDELL COUNTY HEALTH DEPARTMENT

STATESVILLE 704-878-5305 MOORESVILLE 704-664-5281

IMPROVEMENT PERMIT / AUTHORIZATION TO CONSTRUCT / OPERATION PERMIT / EXISTING SYSTEM INSPECTION

PERMIT # 971035 PIN# 4117137410 (PART) DATE 12-31-97

OWNER OR CONTRACTOR DAWN L. GRYDER PHONE: Business Home 872-7767

ADDRESS 168 RISER LANE, STATESVILLE, NC. 28677

LOCATION NC 115N, TL MIDWAY ROAD, TR BAUER DRIVE 300 FEET ON LEFT

SUBDIVISION HONEY POWER BLOCK / SECTION LOT 22-25 LOT AREA 4.0 ACRES SITE CLASS PS DESIGN FLOW 360 L.T.A.R. 0.30 SQD/FT²

Septic Tank: 1000 Gallons: STB 1011 Date 6-2-97

Pump Tank: Gallons: P7 Date

Pump Make: Model Serial No.

Distribution Field: No Fields 1 Square Feet 1200 Linear Feet 400

Trench: 12" Trench Width 36" Max Trench Bottom Depth 36"

New System: Repair System Type: I II III IV V VI

System Description: CONVENTIONAL GRAVITY

Repair System Description: CONV. GRAVITY

Maintenance Agreement Required: Yes No

Gravel Depth: 12" Slab Crawl Space Basement w/plumbing Basement w/o plumbing

House/Mod. Home No. Bedrooms 3

Mobile Home No. Bathrooms 2

Business No. Employees

Other

Water Supply: Individual Public Community WELL

Comments/Conditions: KEEP SYSTEM MINIMUM 100' FROM WELL


KEEP LINES ON CONTOUR, AS PLOTTED

Comments/Conditions:


40 Drainlines checked - upper two lines 18" deep other lines 36" deep

Soils examined 36" below trench bottom

INITIAL SITE SKETCH SCALE: 1" = 60'

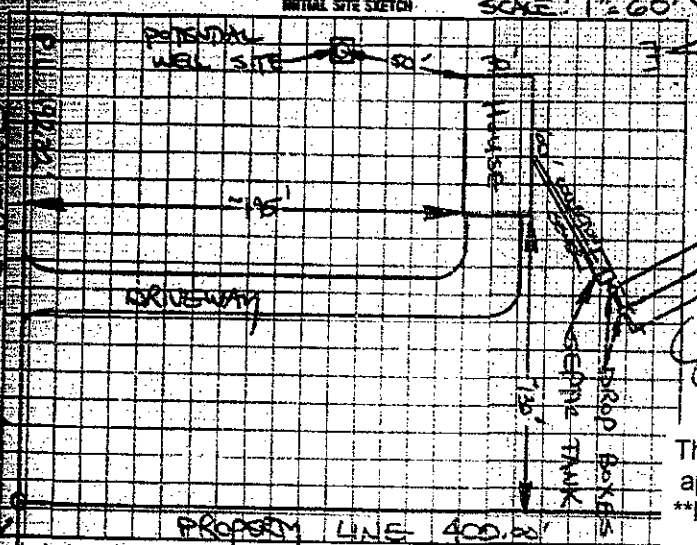

AS BUILT SKETCH

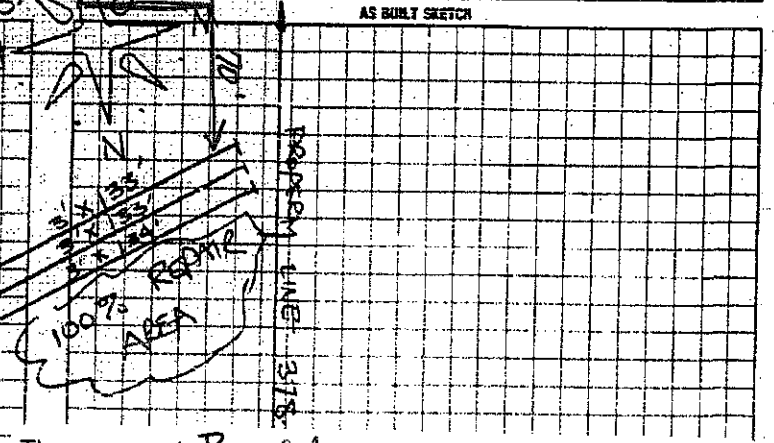

The proposed Building addition does not appear to impact the existing septic system.

**NOTE:

R.S.

Date:

ICHD-Environmental Health Division

I understand that this permit can be suspended or revoked if any false information is supplied toward se tion of the system. Improvement Permit with plat valid without expiration. Improvement Permit with site to exceed sixty months.

Signed: date

Improvement Permit by: STEVE HENDRICK date 12-31-97

Authorization to Construct by: STEVE HENDRICK date 12-31-97

Installed by: SCOT LACKEY (HOMEOWNER)

Operation Permit by: STEVE HENDRICK date 4-11-00

Existing System Inspection by date

HEALTH DEPT COPY WHITE INSPECTION COPY (FINAL) GREEN OWNER COPY (FINAL) YELLOW INSPECTION COPY (INITIAL) PINK OWNER COPY (INITIAL) GOLD

JAN. 7, 1989 12:03