5138

IREDELL COUNTY HEALTH DEPARTMENT

THIS PERMIT VOIDS PREVIOUS ISSUED 5/16/94

STATESVILLE 704-878-5305 MOORESVILLE 704-664-5281

IMPROVEMENT PERMIT / AUTHORIZATION TO CONSTRUCT / OPERATION PERMIT / EXISTING SYSTEM INSPECTION

PERMIT# 18041 PIN# 9Q-A-38

OWNER OR CONTRACTOR DAVID SWANGER DATE 10-30-98

ADDRESS Rt. 8 Box 84-A STATESVILLE, NC 28677 PHONE: Business Home 872-1388

LOCATION NC 115 N, TL MIDWAY ROAD TR BAKER DR, AT END ON RIGHT

SUBDIVISION BLOCK / SECTION LOT LOT AREA ~0.5 ACRE SITE CLASS: PS DESIGN FLOW 360 L.T.A.R. 0.35 GPD/FT²

Septic Tank: 1000 Gallons; STB 1012 Date 8-23-98

Pump Tank: Gallons; PT Date

Pump Make: Model Serial No.

Nitrification Field: No Fields 1 Square Feet EQ. TO 1035 Linear Feet 260±

No Lines THREE Trench Width 36" Max Trench Bottom Depth 36" Depth SAND 64

✓ New System ☐ Repair System Type: I, II, (III) IV, V, VI

System Description: 25% REDUCTION GRAVITY

Repair System Description: PPBPS PUMP

Maintenance Agreement Required: ☐ Yes ☐ No

✓ House/Mod. Home No. Bedrooms 3

☐ Mobile Home No. Bathrooms 2

☐ Business No. Employees

☐ Other


☐ Slab ☐ Crawl Space ☐ Basement w/plumbing ☐ Basement wo/plumbing

Water Supply: ✓ Individual ☐ Public ☐ Community WELL

Comments:/Conditions: INSTALL 25% REDUCTION SYSTEM USING 42 (FORTY-TWO) CHAMBERS AT REQUEST.

Comments:/Conditions:

INITIAL SITE SKETCH SCALE: 1"=50'

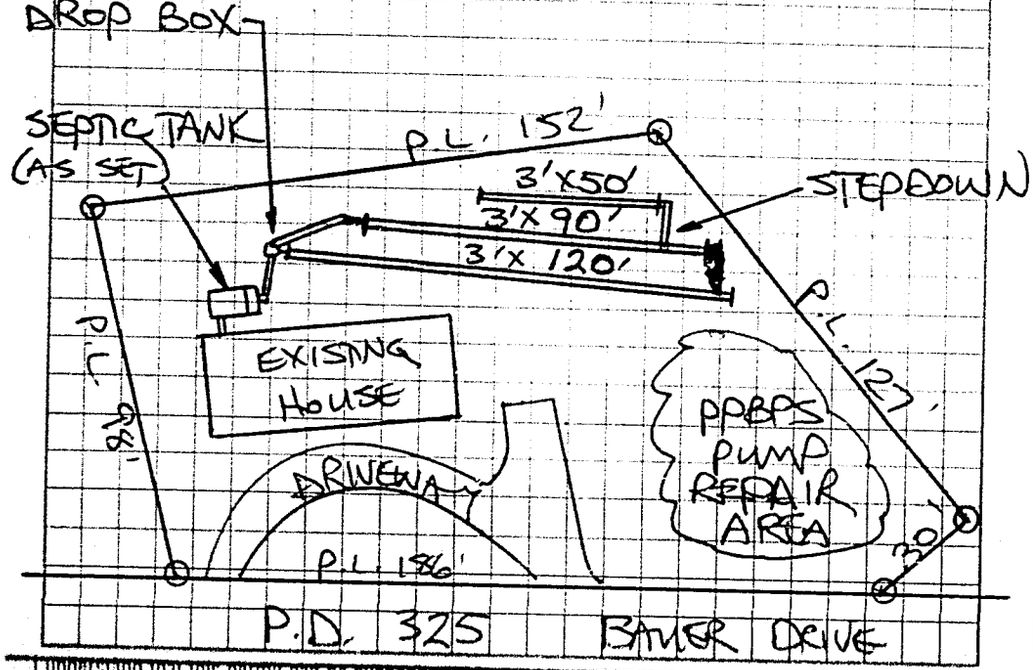

AS BUILT SKETCH

SYSTEM INSTALLED ACCORDING TO INITAL SITE SKETCH

I understand that this permit can be suspended or revoked if any false information is supplied toward securing the permit/any unauthorized changes are made to the site/any unauthorized changes are made in the installation of the system. Improvement Permit with plat valid without expiration. Improvement Permit with site plan valid for sixty months. Authorization to Construct is valid for a period equal to that of Improvement Permit – not to exceed sixty months.

Signed: [signature] date 10/30/98 Installed by: JAMES HUBER

Improvement Permit by: STEVE HEDRICK date 10/30/98 Operation Permit by: STEVE HEDRICK date 11-4-98

Authorization to Construct by: STEVE HEDRICK date 10/30/98 Existing System Inspection by date

HEALTH DEPT COPY WHITE INSPECTION COPY (FINAL) GREEN OWNER COPY (FINAL) YELLOW INSPECTION COPY (INITIAL) PINK OWNER COPY (PERMIT) GOLD