IREDELL COUNTY HEALTH DEPARTMENT

Statesville Office (704) 878-5305 Mooresville Office (704) 660-3625 PERMIT # 210760

IMPROVEMENT PERMIT / AUTHORIZATION TO CONSTRUCT / OPERATION PERMIT / EXISTING SYSTEM

PIN # 4717109533

APPLICANT: Darlene Goforth APPLICANT ADDRESS: 821 Wood St.

SITE ADDRESS: 1051 Midway Rd. PHONE: 704-682-4275 ALT. PHONE: N/A

SITE DIRECTIONS: Hwy 115 N TL Midway Rd. Property on Left.

SUBDIVISION: N/A SECTION: N/A LOT # N/A LOT AREA: 27.46 acres DESIGN FLOW: 240gpd L.T.A.R.: 0.25

Septic Tank 1000 (gal) STB 760-1000 Date 7-6
Pump Tank (gal) PT Date
Pump Make Model Serial #
Nitrification Fields 1 # Lines 3 Linear Ft: 240
Trench Width 36" Max. Trench Bottom Depth 24" Gravel Depth N/A


☑ New System ☐ Repair ☐ Expansion System Type: I II (III) IV V VI
System Description: 25% Reduction
Repair System Description: 25% Reduction
Maintenance Agreement Required: ☐ YES ☑ NO
☑ GRAVITY ☐ PRESSURE

☑ Residence No. Bedrooms 2
☐ Business No. Persons 4
☐ Other No. Employees
☐ Slab ☑ Crawl Space
☐ Basement w/plumbing ☐ Basement w/o plumbing


Water Supply: ☑ Private ☐ Public ☐ Community

Comments / Conditions: IMPROVEMENTS ONLY! Sub-divide Property & record, and submit Floor plan Prior to ISSUANCE of CA! Install a 25% Reduction System on contour with Serial distribution. ★ Install trench bottoms @ 24" on high side ★★

INITIAL SITE SKETCH

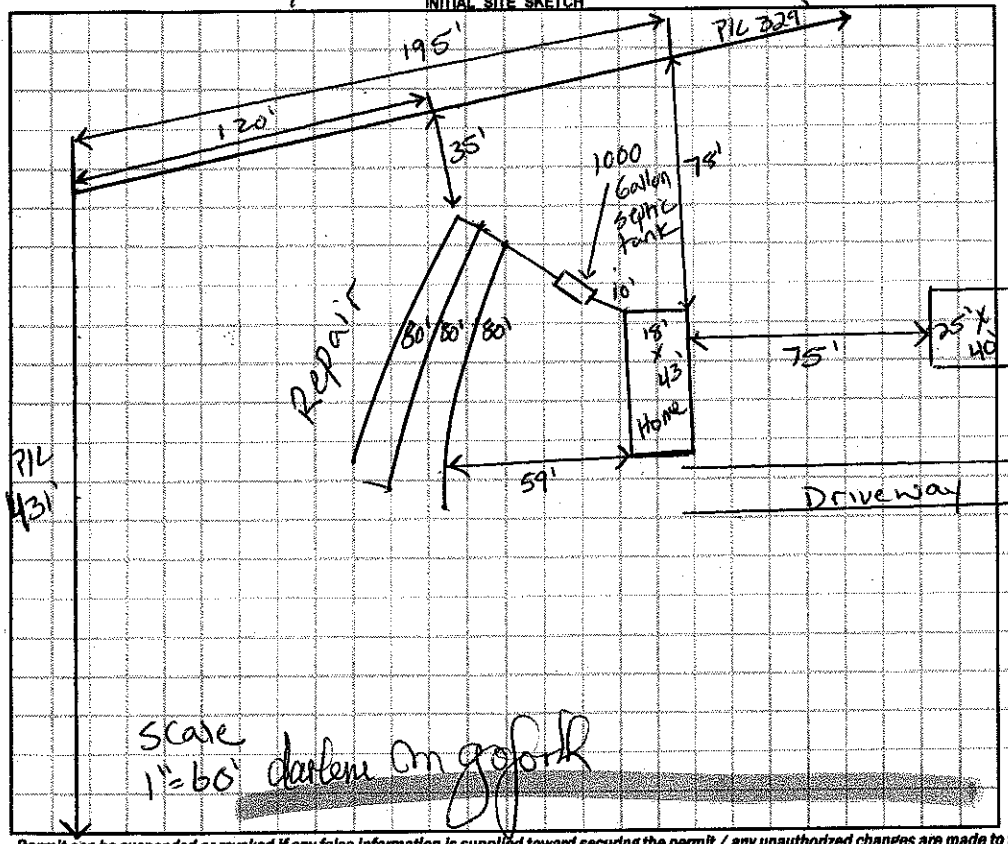

AS BUILT SKETCH

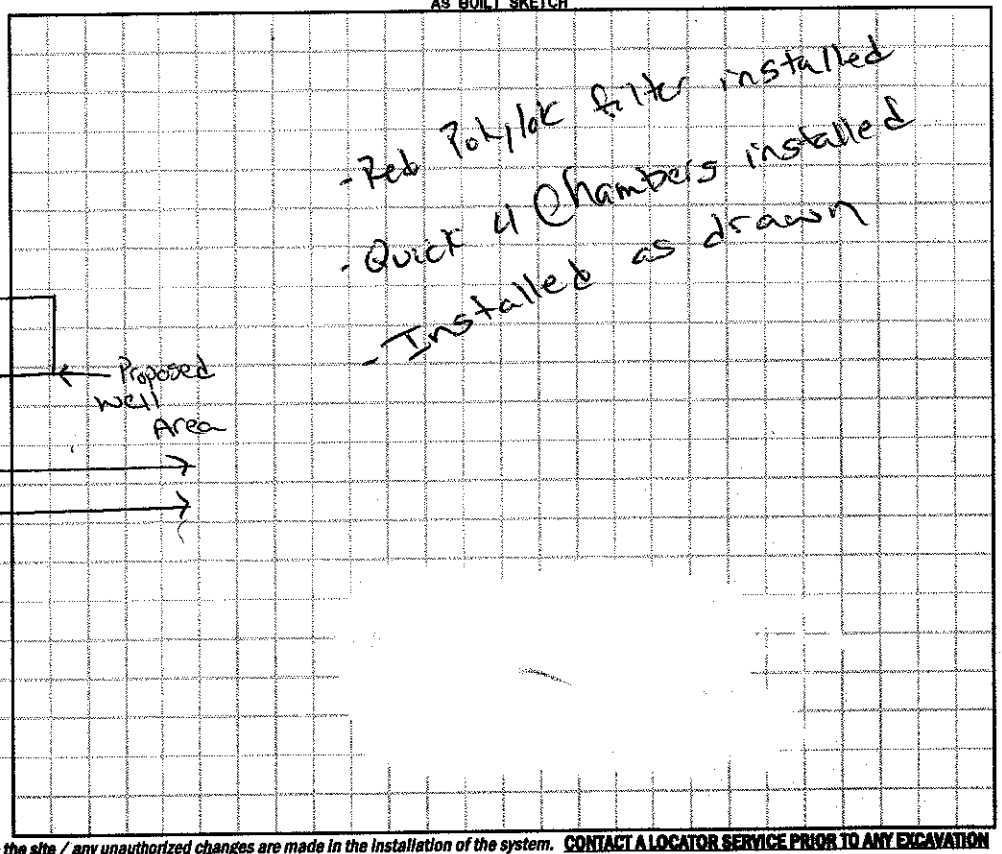

Permit can be suspended or revoked if any false information is supplied toward securing the permit / any unauthorized changes are made to the site / any unauthorized changes are made in the installation of the system. **CONTACT A LOCATOR SERVICE PRIOR TO ANY EXCAVATION**

☐ **IMPROVEMENT PERMIT** *with plat valid without expiration.* ☑ **IMPROVEMENT PERMIT** *with site plan valid for 60 mos.* ☑ **AUTHORIZATION TO CONSTRUCT** *valid for period equal to IMPROVEMENT PERMIT--not to exceed 60 mo.*

Owner / Applicant Signature: darlene ongoforth Date: 6-19-15 Installed by: Ground breakers

IMPROVEMENT PERMIT by: Justin Henderson Date: 6-19-15 OPERATION PERMIT by: Justin Henderson Date: 10-9-15

AUTHORIZATION TO CONSTRUCT by: Justin Henderson Date: 7-6-15 Existing System Inspected by: Date:

Health Dept. Copy - WHITE Applicant (Final Approval) - YELLOW Applicant (Conditional Approval) - PINK