IREDELL COUNTY HEALTH DEPARTMENT

STATESVILLE 704-878-5305 MOORESVILLE 704-664-5281

IMPROVEMENT PERMIT / CERTIFICATE OF COMPLETION / OPERATION PERMIT / EXISTING SYSTEM INSPECTION

PROPERTY DESCRIPTION NO. 19993 DATE 6/16/95 TAX MAP NO. 9K-A-77 (PART) Watershed: ☐ Yes ☑ No

OWNER OR CONTRACTOR EARLIE C. HAGER PHONE: Business Home 876-3154

ADDRESS RT. 8, BOX 69 STATESVILLE NC 28677

LOCATION NC 115, N, TL MIDWAY ROAD, TL MIDWAY MHP, 1ST LR 2ND STREET, 3RD MH on (R)

SUBDIVISION MIDWAY ROAD MHP BLOCK / SECTION II LOT 26 LOT AREA 100 x 155 SITE CLASS PS DESIGN FLOW 300 L.T.A.R. 0.3 GPD/FT²

Septic Tank: 1000 Gallons; STB 1600 Date 5/17/95

Pump Tank: ____ Gallons; PT ____ Date ____

Pump Make ____ Model ____ Serial No. ____

Nitrification Field: No Fields 1 Square Feet 1200 Linear Feet 400

No Lines 4 Trench Width 36" Max Trench Bottom Depth 18-36" Gravel Depth 12"

☑ New System ☐ Repair System Type: I (II) III, IV, V, VI

System Description: CONV. GRAVITY

Repair System Description: CONV. GRAVITY

Maintenance Agreement Required: ☐ Yes ☑ No

☐ House/Mod. Home ☑ Mobile Home ☐ Business ☐ Other

No. Bedrooms 3 No. Bathrooms 2 No. Employees ____


☐ Slab ☑ Crawl Space ☐ Basement w/plumbing ☐ Basement wo/plumbing

Water Supply: ☐ Individual ☐ Community ☑ Public


Comments:

Comments: SYSTEM INSTALLED ACCORDING TO INITAL SITE SKETCH

INITIAL SITE SKETCH

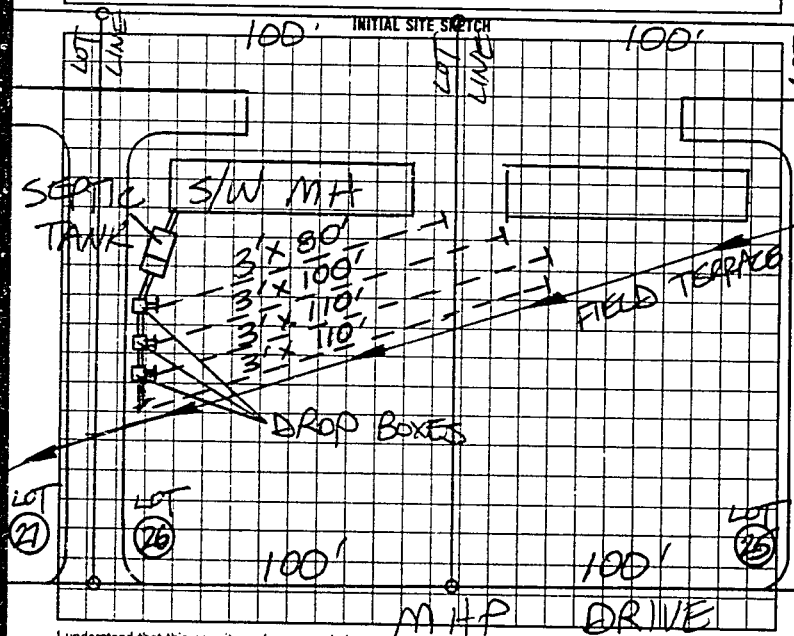

AS BUILT SKETCH

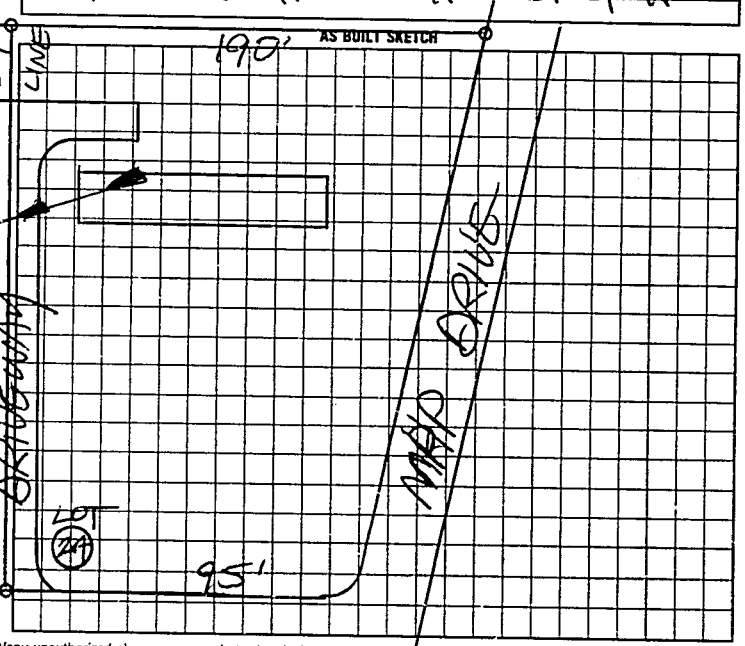

I understand that this permit can be suspended or revoked if any false information is supplied toward securing the permit/any unauthorized changes are made to the site/any unauthorized changes are made in the installation of the system. Improvement Permit is valid for 60 months from date of issuance.

Signed: Earlie Hager

Improvement Permit by: STEVE HEDRICK date 6/16/95

Existing System Inspection by: ____ date ____

Installed by: RHYNE BYERS

Certificate of Completion by: STEVE HENRICK date 6/19/95

Operation Permit by: ____ date ____

HEALTH DEPT. COPY: WHITE INSPECTION COPY (FINAL): GREEN OWNER COPY (FINAL): YELLOW INSPECTION COPY (INITIAL): PINK OWNER COPY (INITIAL): GOLD

8 9 7 0 0 0