IREDELL COUNTY HEALTH DEPARTMENT

STATESVILLE 704-878-5305 MOORESVILLE 704-664-5281

IMPROVEMENT PERMIT / CERTIFICATE OF COMPLETION / OPERATION PERMIT / EXISTING SYSTEM INSPECTION

PROPERTY DESCRIPTION NO. 19995 DATE 6/20/95 TAX MAP NO. 9K-A-77 (PART) Watershed: ☐ Yes ☑ No

OWNER OR CONTRACTOR EARLIE C. HAGER PHONE: Business _____ Home 876-3154

ADDRESS RT. 8 BOX 69 STATESVILLE NC 28677

LOCATION NC 115 N, TL MIDWAY RD TL MIDWAY MHP TR 2ND STREET, 5TH LOT ON RIGHT

SUBDIVISION MIDWAY MHP BLOCK / SECTION II LOT 28 LOT AREA 100x155' SITE CLASS. PS DESIGN FLOW 360 L.T.A.R. 0.3 gpd/ft²

Septic Tank: 1000 Gallons; STB 160 Date 6-20-95

Pump Tank: _____ Gallons; PT _____ Date _____

Pump Make: _____ Model _____ Serial No. _____

Nitrification Field: No Fields 1 Square Feet 1200 Linear Feet 400

No Lines 5 Trench Width 36" Max Trench Bottom Depth 18-36" Gravel Depth 12"

☑ New System ☐ Repair System Type: ☐ I ☐ II ☐ III ☐ IV ☐ V ☐ VI

System Description: CONV. GRAVITY

Repair System Description: CHAMBERED GRAVITY

Maintenance Agreement Required: ☐ Yes ☑ No

☐ House/Mod. Home No. Bedrooms 3

☑ Mobile Home No. Bathrooms 2

☐ Business No. Employees ____

☐ Other _____


☐ Slab ☑ Crawl Space ☐ Basement w/plumbing ☐ Basement wo/plumbing

Water Supply: ☐ Individual ☐ Community ☑ Public

Comments:

Comments:

INITIAL SITE SKETCH

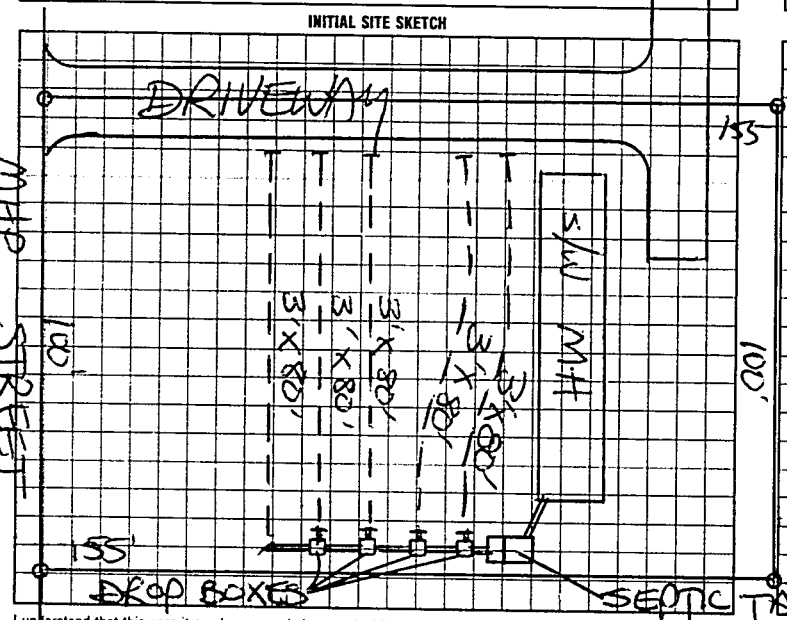

AS BUILT SKETCH

SYSTEM INSTALLED ACCORDING TO INITIAL SITE SKETCH

I understand that this permit can be suspended or revoked if any false information is supplied toward securing the permit/any unauthorized changes are made to the site/any unauthorized changes are made in the installation of the system. Improvement Permit is valid for 60 months from date of issuance.

Signed: Earlie Hager

Improvement Permit by: STEVE HENDRICK date 6/20/95

Existing System Inspection by: _____ date _____

Installed by: Rayne Byers

Certificate of Completion by: STEVE HENDRICK date 7-21-95

Operation Permit by: _____ date _____

HEALTH DEPT. COPY (WHITE) INSPECTION COPY (FINAL) GREEN OWNER COPY (FINAL) YELLOW INSPECTION COPY (INITIAL) PINK OWNER COPY (INITIAL) GOLD