IREDELL COUNTY HEALTH DEPARTMENT

STATESVILLE 704-878-5305 MOORESVILLE 704-664-5281

IMPROVEMENT PERMIT / CERTIFICATE OF COMPLETION / OPERATION PERMIT / EXISTING SYSTEM INSPECTION

PROPERTY DESCRIPTION NO. 199916 DATE 6/21/95 TAX MAP NO. 9K-A-77 (PART) Watershed: ☐ Yes ☑ No

OWNER OR CONTRACTOR EARLE C. HAGER PHONE: Business Home 876-3154

ADDRESS R-8 BOX 69 STATESVILLE NC 28677

LOCATION NC 115 N. TO MIDWAY RD. TO MIDWAY MHP, TR 2ND STREET 6TH LOT ON (R)

SUBDIVISION MIDWAY MHP BLOCK / SECTION II LOT 29 LOT AREA 100 x 155 SITE CLASS. PS DESIGN FLOW 240 L.T.A.R. 0.3 GPD/FT²

Septic Tank: 1000 Gallons; STB 1600 Date 6-11-95

Pump Tank: _____ Gallons; PT _____ Date _____

Pump Make: _____ Model _____ Serial No. _____

Nitrification Field: No Fields 1 Square Feet 810 Linear Feet 270

No Lines 4 Trench Width 36" Max Trench Bottom Depth 18-36" Gravel Depth 12"

☑ New System ☐ Repair System Type: I, II, III, IV, V, VI

System Description: CONVENTIONAL GRAVITY

Repair System Description: CHAMBERED GRAVITY

Maintenance Agreement Required: ☐ Yes ☑ No

☐ House/Mod. Home No. Bedrooms 2

☑ Mobile Home No. Bathrooms 2

☐ Business No. Employees ____

☐ Other 240 GPD

☐ Slab ☑ Crawl Space ☐ Basement w/plumbing ☐ Basement wo/plumbing


Water Supply: ☐ Individual ☐ Community ☑ Public

Comments:

SYSTEM DESIGNED FOR 2BR MH AT 240 GPD.

Comments:

INITIAL SITE SKETCH

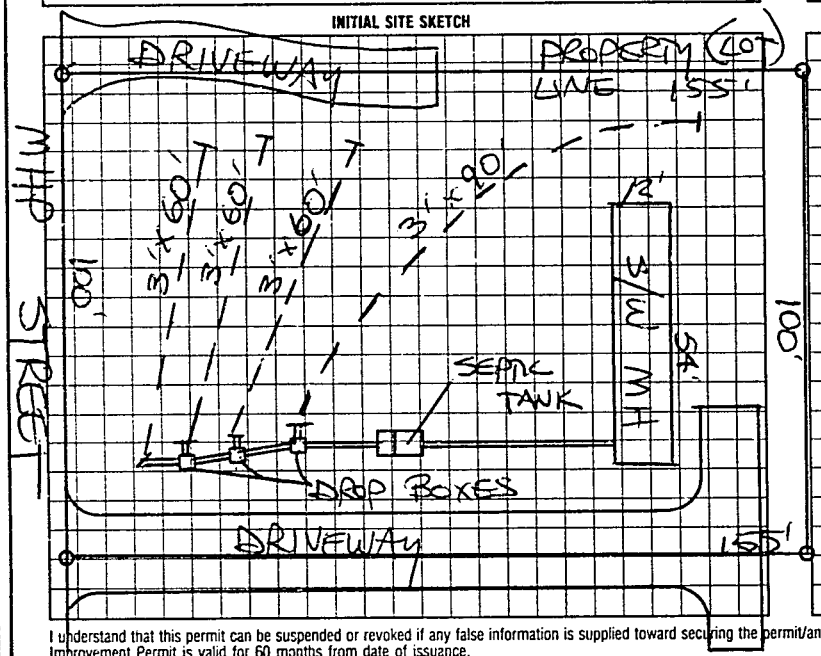

AS BUILT SKETCH

SYSTEM INSTALLED ACCORDING TO INITAL SITE SKETCH

I understand that this permit can be suspended or revoked if any false information is supplied toward securing the permit/any unauthorized changes are made to the site/any unauthorized changes are made in the installation of the system. Improvement Permit is valid for 60 months from date of issuance.

Signed. Earle Hager

Improvement Permit by: STEVE HEDRICK date 6-21-95

Existing System Inspection by _____ date _____

Installed by: RHYNE BYERS

Certificate of Completion by: STEVE HEDRICK date 7-21-95

Operation Permit by _____ date _____

HEALTH DEPT. COPY: WHITE INSPECTION COPY (FINAL): GREEN OWNER COPY (FINAL): YELLOW INSPECTION COPY (INITIAL): PINK OWNER COPY (INITIAL): GOLD

6 7 7 0 0 0