IREDELL COUNTY HEALTH DEPARTMENT

STATESVILLE 704-878-5305 MOORESVILLE 704-664-5281

IMPROVEMENT PERMIT / CERTIFICATE OF COMPLETION / OPERATION PERMIT / EXISTING SYSTEM INSPECTION

PROPERTY DESCRIPTION NO. 19999 DATE 5/26/95 TAX MAP NO. 9K-A-77 (PT) Watershed: ☐ Yes ☐ No

OWNER OR CONTRACTOR EARLIE C. HAGER PHONE: Business Home 876-3154

ADDRESS RT-8, Box 69 STVL, NC 28677

LOCATION NC 115 N, TL MIDWAY RD TL MIDWAY MHP 2ND STREET TR, NEXT TO LAST MH ON LEFT

SUBDIVISION MIDWAY MHP BLOCK / SECTION LOT 33/34 LOT AREA LIMITED SITE CLASS. PS DESIGN FLOW 360 L.T.A.R. 0.36

Septic Tank: 1000 Gallons; STB 160 Date 4/27/95

Pump Tank: Gallons; PT Date

Pump Make: Model Serial No.

Nitrification Field: No Fields 1 Square Feet 1200 Linear Feet 400

No Lines 4 Trench Width 36" Max Trench Bottom Depth 36" Gravel Depth 12"

☐ New System ☐ Repair System Type: I, II, III, IV, V, VI

System Description: CONV, GRAVITY

Repair System Description: CHAMBERED GRAVITY

Maintenance Agreement Required: ☐ Yes ☐ No

☐ House/Mod. Home ☐ Mobile Home ☐ Business ☐ Other

No. Bedrooms 3 No. Bathrooms 2 No. Employees


☐ Slab ☐ Crawl Space ☐ Basement w/plumbing ☐ Basement wo/plumbing

Water Supply: ☐ Individual ☐ Community ☐ Public


Comments:

Comments:

INITIAL SITE SKETCH

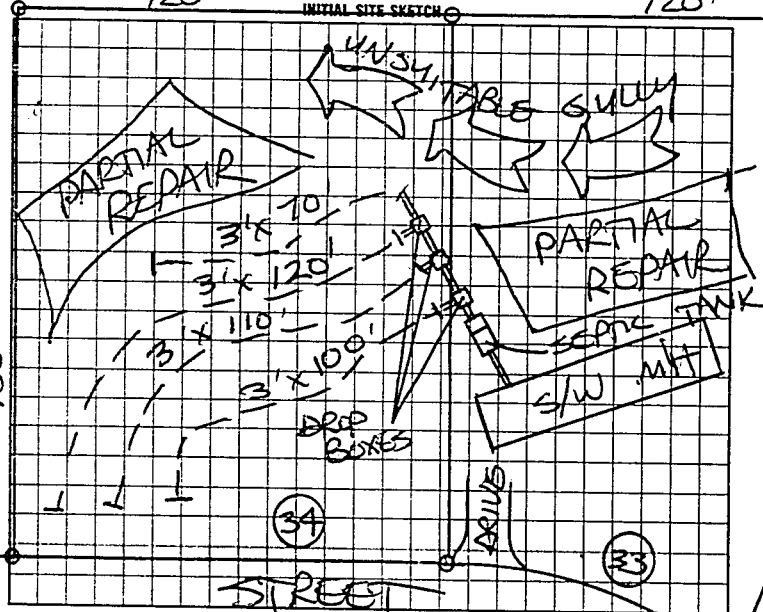

AS BUILT SKETCH

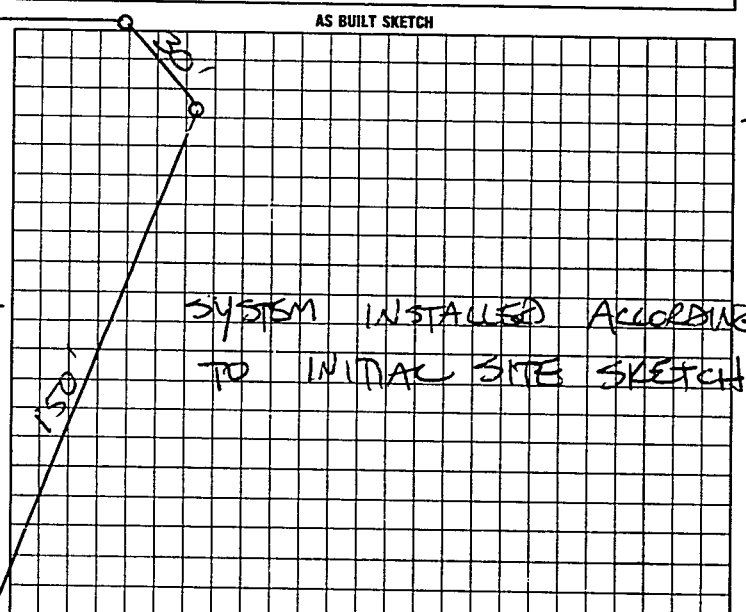

I understand that this permit can be suspended or revoked if any false information is supplied toward securing the permit/any unauthorized changes are made to the site/any unauthorized changes are made in the installation of the system. Improvement Permit is valid for 60 months from date of issuance.

Signed: X Rhyne Byers

Improvement Permit by: STEVE HEDRICK date 5/26/95

Existing System Inspection by: date

Installed by: RHYNE BYERS

Certificate of Completion by: STEVE HEDRICK date 6/14/95

Operation Permit by: date

HEALTH DEPT COPY WHITE INSPECTION COPY (FINAL) GREEN OWNER COPY (FINAL) YELLOW INSPECTION COPY (INITIAL) PINK OWNER COPY (INITIAL) GOLD

9 5 7 0 0 0