IREDELL COUNTY HEALTH DEPARTMENT

STATESVILLE 704-878-5305 MOORESVILLE 704-664-5281

IMPROVEMENT PERMIT / CERTIFICATE OF COMPLETION / OPERATION PERMIT / EXISTING SYSTEM INSPECTION

PROPERTY DESCRIPTION NO. 20002 DATE 5/15/95 TAX MAP NO. 9K-A-77 (PART OF) Watershed: ☐ Yes ☒ No

OWNER OR CONTRACTOR EARLIE C. HAGER PHONE: Business Home 876-3154

ADDRESS RT 8, Box 69 STATESVILLE, NC 28677

LOCATION NC 115 N, ~~[illegible]~~ TL MIDWAY RD, TL MIDWAY RD MHP, 2ND STREET BACK - LOT AT END ON LEFT

SUBDIVISION MIDWAY ROAD MHP BLOCK / SECTION II LOT 36 LOT AREA AMPLE SITE CLASS P3 DESIGN FLOW 360 L.T.A.R. 0.30 GPD/FT²

Septic Tank: 1000 Gallons; STB 160 Date 4/26/95

Pump Tank: ____ Gallons; PT ____ Date ____

Pump Make: ____ Model ____ Serial No. ____

Nitrification Field: No Fields 1 Square Feet 1200 Linear Feet 400

No Lines 4 Trench Width 36" Max Trench Bottom Depth 18-36" Gravel Depth 12"

☒ New System ☐ Repair System Type: I, II, III, IV, V, VI

System Description: CONVENTIONAL GRAVITY

Repair System Description: CONVENTIONAL GRAVITY

Maintenance Agreement Required: ☐ Yes ☒ No

☐ House/Mod. Home ☒ Mobile Home ☐ Business ☐ Other

No. Bedrooms 3 No. Bathrooms 2 No. Employees ____


☐ Slab ☒ Crawl Space ☐ Basement w/plumbing ☐ Basement w/o plumbing

Water Supply: ☐ Individual ☐ Community ☒ Public


Comments:

Comments:

INITIAL SITE SKETCH

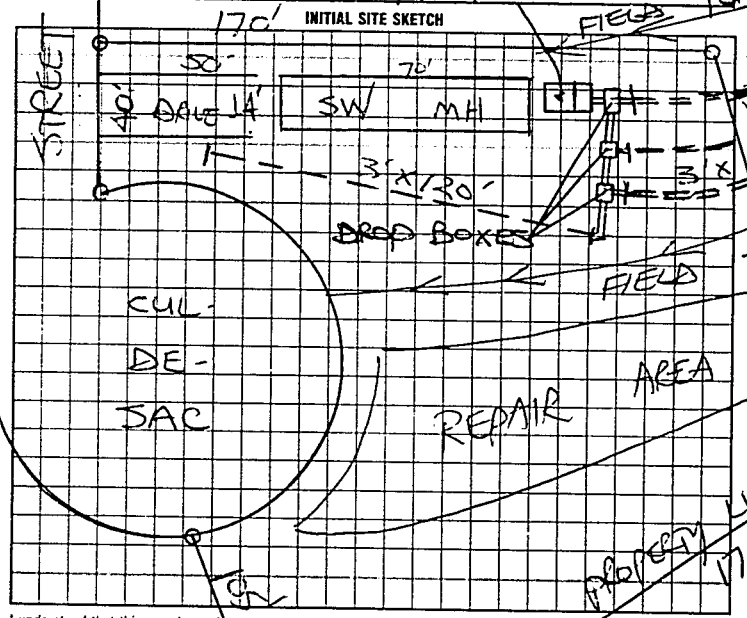

AS BUILT SKETCH

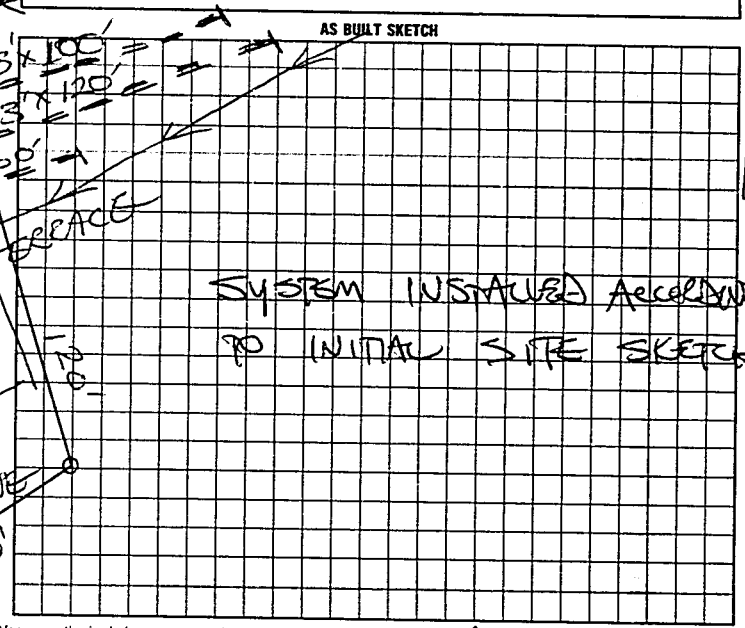

I understand that this permit can be suspended or revoked if any false information is supplied toward securing the permit/any unauthorized changes are made to the site/any unauthorized changes are made in the installation of the system. Improvement Permit is valid for 60 months from date of issuance.

Signed: Earlie Hager

Improvement Permit by: STEVE HENDRICK date 5/5/95

Existing System Inspection by: ____ date ____

Installed by: RHYNE BYERS, EARLIE HAGER

Certificate of Completion by: STEVE HENDRICK date 5/26/95

Operation Permit by: ____ date ____

HEALTH DEPT. COPY: WHITE INSPECTION COPY (FINAL): GREEN OWNER COPY (FINAL): YELLOW INSPECTION COPY (INITIAL): PINK OWNER COPY (INITIAL): GOLD

087000