TR Midway, 1 mi IR Dist

IREDELL COUNTY HEALTH DEPARTMENT

STATESVILLE 704-878-5305 MOORESVILLE 704-664-5281

IMPROVEMENT PERMIT / CERTIFICATE OF COMPLETION / OPERATION PERMIT / EXISTING SYSTEM INSPECTION

PROPERTY DESCRIPTION NO. 20003 DATE 5/5/95 TAX MAP NO. 9K-A-77 (PART OF) Watershed: ☐ Yes ☑ No

OWNER OR CONTRACTOR EARLE C HAGER PHONE: Business _____ Home 876-3154

ADDRESS RT 8 Box 69 STATESVILLE NC 28677

LOCATION NC 115 N, TL MIDWAY RD, TL MIDWAY RD MHP 7TH LOT ON LEFT ON 2ND STREET BACK

SUBDIVISION MIDWAY ROAD MHP BLOCK / SECTION II LOT 37 LOT AREA 60x170x90x170 SITE CLASS. PS DESIGN FLOW 360 L.T.A.R. 0.3 GPD/SF

Septic Tank: 1000 Gallons; STB 160 Date 4/14/95

Pump Tank: _____ Gallons; PT _____ Date _____

Pump Make: _____ Model _____ Serial No. _____

Nitrification Field: No Fields 1 Square Feet 1200 Linear Feet 400

No Lines 4 Trench Width 36" Max Trench Bottom Depth 36" Gravel Depth 12"

☑ New System ☐ Repair System Type: I, II, III, IV, V, VI

System Description: CONV. GRAVITY

Repair System Description: _____

Maintenance Agreement Required: ☐ Yes ☑ No

☐ Slab ☑ Crawl Space ☐ Basement w/plumbing ☐ Basement wo/plumbing

☐ House/Mod. Home No. Bedrooms 3

☑ Mobile Home No. Bathrooms 2

☐ Business No. Employees _____


☐ Other _____

Water Supply:
☐ Individual
☑ Community
☑ Public

Comments:

Comments:

INITIAL SITE SKETCH

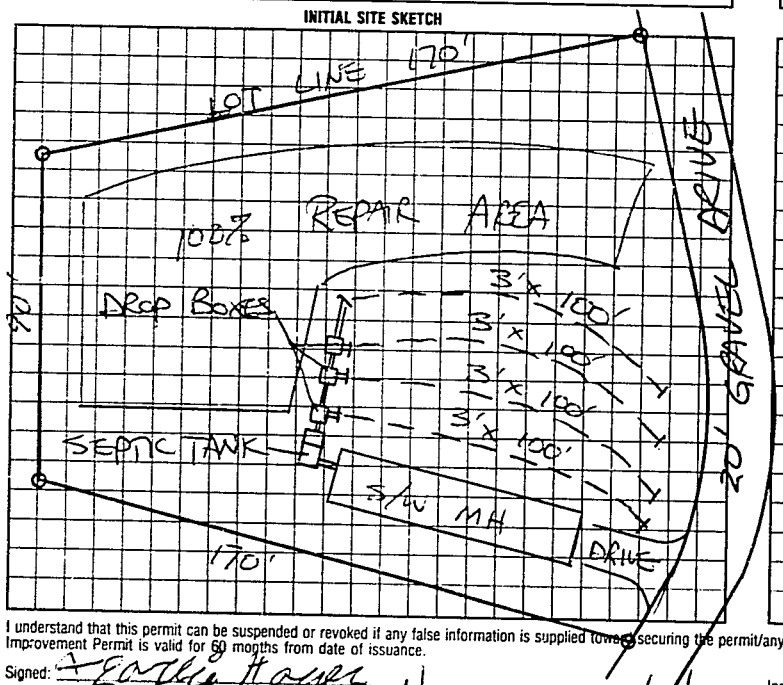

AS BUILT SKETCH

SYSTEM INSTALLED ACCORDING TO INITIAL SITE SKETCH

I understand that this permit can be suspended or revoked if any false information is supplied towards securing the permit/any unauthorized changes are made to the site/any unauthorized changes are made in the installation of the system. Improvement Permit is valid for 60 months from date of issuance.

Signed: Earlie Hager

Improvement Permit by: STEVE HEDRICK date 5/5/95

Existing System Inspection by: _____ date _____

Installed by: RHYNE BYERS / EARLE HAGER

Certificate of Completion by: STEVE HEDRICK date 5/24/95

Operation Permit by _____ date _____

HEALTH DEPT. COPY: WHITE INSPECTION COPY (FINAL): GREEN OWNER COPY (FINAL): YELLOW INSPECTION COPY (INITIAL): PINK OWNER COPY (INITIAL): GOLD