IREDELL COUNTY HEALTH DEPARTMENT

STATESVILLE 704-878-5305 MOORESVILLE 704-664-5281

IMPROVEMENT PERMIT / CERTIFICATE OF COMPLETION / OPERATION PERMIT / EXISTING SYSTEM INSPECTION

PROPERTY DESCRIPTION NO. 20005 DATE 1/26/95 TAX MAP NO. 9K-A-77 (PART) Watershed: ☐ Yes ☒ No

OWNER OR CONTRACTOR EARLIE C. HAGER PHONE: Business Home 876-3154

ADDRESS RT 8, BOX 69 STATESVILLE, NC 28677

LOCATION NC 115 N TL 500 TO 3 CREEK RD, MHP ON (L) ~4.0 MILES, 5TH LOT ON (L) ON BACK STREET

SUBDIVISION MIDWAY RD MHP BLOCK / SECTION IL LOT 39 LOT AREA AMPLE SITE CLASS PS DESIGN FLOW 360 LTAR 0.30 GPD/FT²

Septic Tank 1000 Gallons; STD 160 Date 1/17/95
Pump Tank: _____ Gallons; PT _____ Date _____
Pump Make: _____ Model _____ Serial No. _____
Nitrification Field: No Fields 1 Square Feet 1200 Linear Feet 400
No Lines 4 Trench Width 36" Max Trench Bottom Depth 18-36" Gravel Depth 12"

☐ New System ☐ Repair System Type: I, II, III, IV, V, VI
System Description: CONVENTIONAL GRAVITY
Repair System Description: CONV. GRAVITY
Maintenance Agreement Required: ☐ Yes ☒ No
☐ Slab ☐ Crawl Space ☐ Basement w/plumbing ☐ Basement wo/plumbing


☐ House/Mod. Home No. Bedrooms 3
☒ Mobile Home No. Bathrooms 2
☐ Business No. Employees ____
☐ Other

Water Supply:
☐ Individual
☐ Community
☒ Public

Comments:

Comments:

INITIAL SITE SKETCH

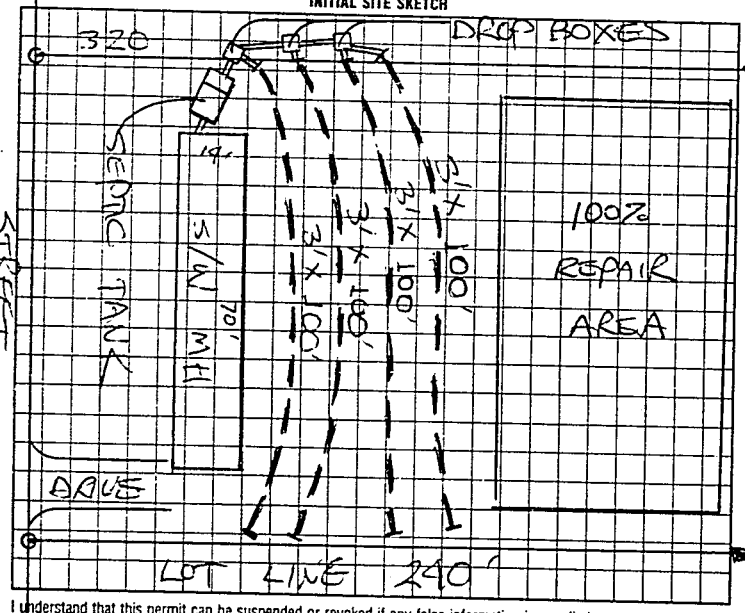

AS BUILT SKETCH

SYSTEM INSTALLED ACCORDING TO INITIAL SITE SKETCH

I understand that this permit can be suspended or revoked if any false information is supplied toward securing the permit/any unauthorized changes are made to the site/any unauthorized changes are made in the installation of the system. Improvement Permit is valid for 60 months from date of issuance.

Signed: Earlie Hager

Improvement Permit by: STEVE HEDRICK date 1/26/95

Existing System Inspection by: _____ date _____

Installed by: EARLIE HAGER

Certificate of Completion by: STEVE HEDRICK date 4/24/95

Operation Permit by _____ date _____

HEALTH DEPT COPY: WHITE INSPECTION COPY (FINAL): GREEN OWNER COPY (FINAL): YELLOW INSPECTION COPY (INITIAL): PINK OWNER COPY (INITIAL): GOLD