IREDELL COUNTY HEALTH DEPARTMENT

STATESVILLE 704-878-5305 MOORESVILLE 704-664-5281

IMPROVEMENT PERMIT / CERTIFICATE OF COMPLETION / OPERATION PERMIT / EXISTING SYSTEM INSPECTION

PROPERTY DESCRIPTION NO. 20051 DATE 5/5/95 TAX MAP NO. 9K-A-77 (PART OF) Watershed: ☐ Yes ☑ No

OWNER OR CONTRACTOR EARLIE C. HAGER PHONE: Business Home 876-3154

ADDRESS RT-8 BOX 69 STATESVILLE NC 28677

LOCATION NC115N TL MIDWAY RD TL MIDWAY MHP 1ST LOT ON LEFT ON 2ND STREET BACK

SUBDIVISION MIDWAY RD MHP BLOCK / SECTION II LOT 43 LOT AREA 130x150x115x195 SITE CLASS. PS DESIGN FLOW 240 L.T.A.R. 0.27 GPD/FT

Septic Tank: 1000 Gallons; STB 160 Date 4/18/95

Pump Tank: ____ Gallons; PT ____ Date ____

Pump Make: ____ Model ____ Serial No. ____

Nitrification Field: No Fields 1 Square Feet 900 Linear Feet 300

No Lines 3 Trench Width 36" Max Trench Bottom Depth 36" Gravel Depth 12"

☑ New System ☐ Repair System Type: I, II, IV, V, VI

System Description: CONV. GRAVITY

Repair System Description: CONV. GRAVITY

Maintenance Agreement Required: ☐ Yes ☐ No

☐ Slab ☑ Crawl Space ☐ Basement w/plumbing ☐ Basement wo/plumbing

☐ House/Mod. Home No. Bedrooms 3

☑ Mobile Home No. Bathrooms 2

☐ Business No. Employees ____


☐ Other ____

Water Supply: ☐ Individual ☑ Community ☑ Public

Comments:

Comments:

INITIAL SITE SKETCH

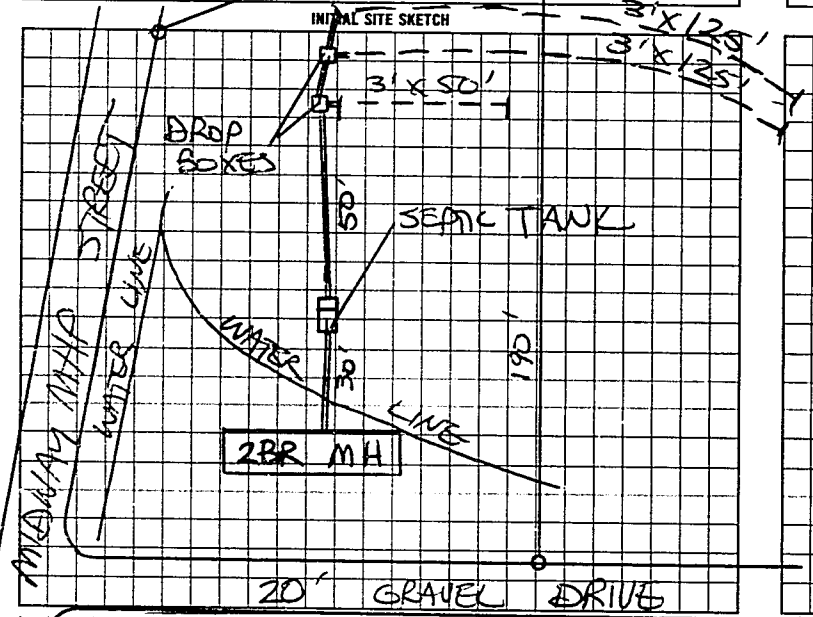

AS BUILT SKETCH

SYSTEM INSTALLED ACCORDING TO INITAL SITE SKETCH

I understand that this permit can be suspended or revoked if any false information is supplied toward securing the permit/any unauthorized changes are made to the site/any unauthorized changes are made in the installation of the system. Improvement Permit is valid for 60 months from date of issuance.

Signed: +Earlie Hager

Improvement Permit by: STEVE HENDRICK date 5/5/95

Existing System Inspection by: date

Installed by: RHYNE BYERS / EARLIE HAGER

Certificate of Completion by: STEVE HENDRICK date 5/22/95

Operation Permit by: date

HEALTH DEPT COPY WHITE INSPECTION COPY (FINAL) GREEN OWNER COPY (FINAL) YELLOW INSPECTION COPY (INITIAL) PINK OWNER COPY (INITIAL) GOLD

261000