IREDELL COUNTY HEALTH DEPARTMENT - *ENVIRONMENTAL HEALTH* ☑ STATESVILLE OFFICE 704-878-5305 ☐ MOORESVILLE OFFICE 704-664-5281

IMPROVEMENT PERMIT / AUTHORIZATION TO CONSTRUCT / OPERATION PERMIT / EXISTING SYSTEM INSPECTION

PERMIT # 172693 PIN # 4717215935 DATE 5-29-12

OWNER Edith Byers APPLICANT: Edith Byers PHONE: Home/Cell # 704-876-1193 Business # N/A

SITE ADDRESS 118 Ken Ln. Statesville OWNER / APPLICANT ADDRESS 491 Cove Gap Rd. Statesville NC 28625

SITE DIRECTIONS 115 N; Turn L on Midway; Turn L Stanley; Turn R on Ken, 4th Spot on Right

SUBDIVISION BLOCK / SECTION LOT # LOT AREA 28.4 acres DESIGN FLOW 360 gpd. L.T.A.R. 0.3

Septic Tank 1000 Gallons: STB 160 Date 5-6-95
Pump Tank Gallons: P T Date
Pump Make Model Serial #
No. Nitrification Fields: 1 No. Lines 5 Linear Feet 400
Trench Width 36" Max. Trench Bottom Depth 18-36" Gravel Depth 12"

☐ New System ☐ Repair ☐ Expansion System Type I (II) III IV V VI
System Description: Conventional Gravity
Repair System Description: 2590 Red
Maintenance Agreement Required ☐ YES ☑ NO
☑ GRAVITY ☐ PRESSURE

☑ Residence No. Bedrooms 3
☐ Business No. Persons
☐ Other No. Employees
☐ Slab ☐ Crawl Space
☐ Basement w/plumbing ☐ Basement w/o plumbing


Water Supply: ☐ Private ☑ Public ☐ Community

Comments / Conditions

- Place SWMH (118) in exact location as previous SWMH, maintaing a min. of 5' between SWMH and all components of STS.

INITIAL SITE SKETCH

AS BUILT SKETCH

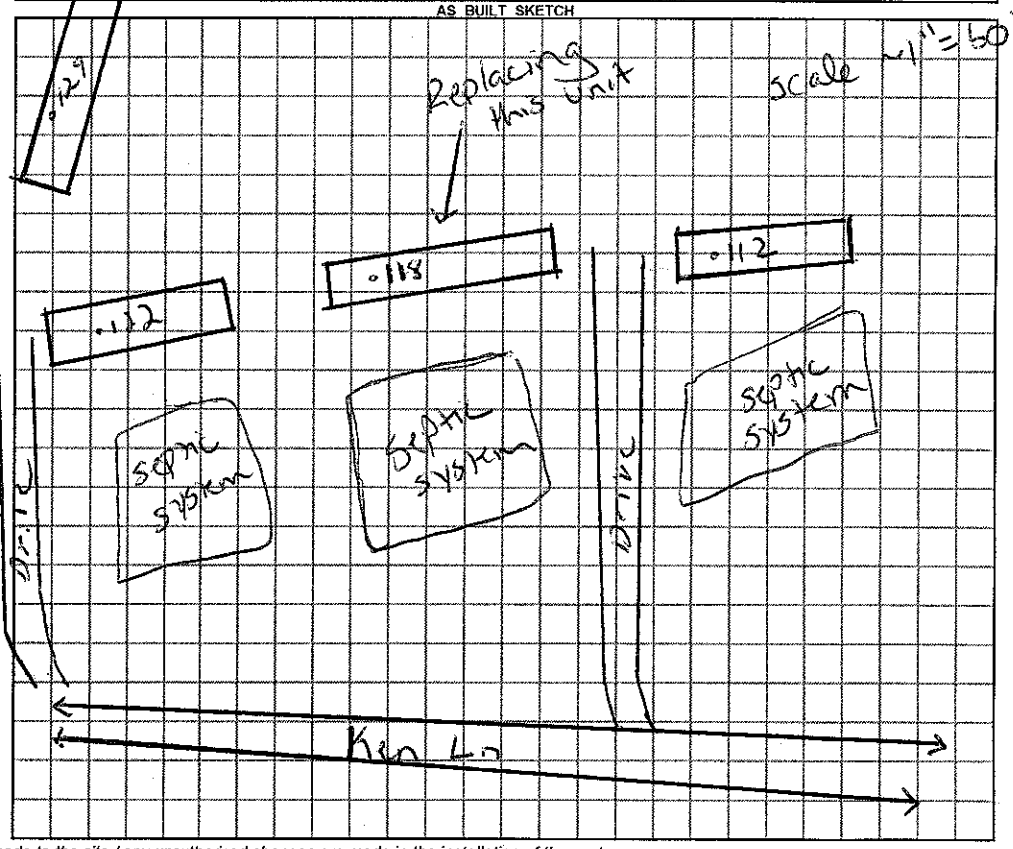

Permit can be suspended or revoked if any false information is supplied toward securing the permit / any unauthorized changes are made to the site / any unauthorized changes are made in the installation of the system.

☐ ***IMPROVEMENT PERMIT*** *with plat valid without expiration.* ☐ ***IMPROVEMENT PERMIT*** *with plat valid without expiration. site plan valid 60 mo.* ☐ ***AUTHORIZATION TO CONSTRUCT*** valid for period equal to IMPROVEMENT PERMIT--not to exceed 60 mo.

Owner / Applicant Signature: Date Installed by:

IMPROVEMENT PERMIT by: ***REHS*** Date OPERATION PERMIT by: ***REHS*** Date

AUTHORIZATION TO CONSTRUCT by: ***REHS*** Date Existing System Inspected by: Justin Henderson ***REHS*** Date 5-29-12

YOU SHOULD CONTACT A LOCATOR SERVICE PRIOR TO ANY EXCAVATION

White Copy – Environmental Health YELLOW COPY (Final) Owner / Applicant PINK COPY (Initial) Owner / Applicant