IREDELL COUNTY HEALTH DEPARTMENT

STATESVILLE 704-878-5305 CI MOORESVILLE 704-664-5281

IMPROVEMENT PERMIT / AUTHORIZATION TO CONSTRUCT / OPERATION PERMIT / EXISTING SYSTEM INSPECTION

PERMIT# 137667 PIN# 4717293715 1994 DATE 10/12/06

OWNER OR APPLICANT Wilson D Ellis PHONE: Business _____ Home _____

ADDRESS Liberty Hill

LOCATION Hwy 115N, left on Midway - R Liberty Hill Rd. Property on (R)

SUBDIVISION n/a BLOCK / SECTION _____ LOT _____ LOT AREA 66.37A SITE CLASS. PS DESIGN FLOW 360 L.T.A.R. .2

Septic Tank: 1000 Gallons: STB 901 Date 4-18-08
Pump Tank: _____ Gallons: PT _____ Date _____
Pump Make: _____ Model _____ Serial No. _____
Nitrification Field: No Fields 1 Square Feet 1800 Linear Feet 450
No Lines 5 Trench Width 36" Max Trench Bottom Depth 30"

☒ New System ☐ Repair ☐ Expansion System Type: I II (III) IV V VI
System Description: 25% Reduction
Repair System Description: 25% Reduction
Maintenance Agreement Required: ☐ Yes ☒ No

☒ House/Mod. Home No. Bedrooms 3
☐ Mobile Home No. Persons _____
☐ Business No. Employees _____
☐ Other _____


Water Supply: ☒ Individual ☐ Public ☐ Community

Gravel Depth N/A ☒ Gravity ☐ Pressure ☐ Slab ☐ Crawl Space ☐ Basement w/plumbing ☐ Basement wo/plumbing

Comments:/Conditions:

Comments:/Conditions:
Red Flags

INITIAL SITE SKETCH

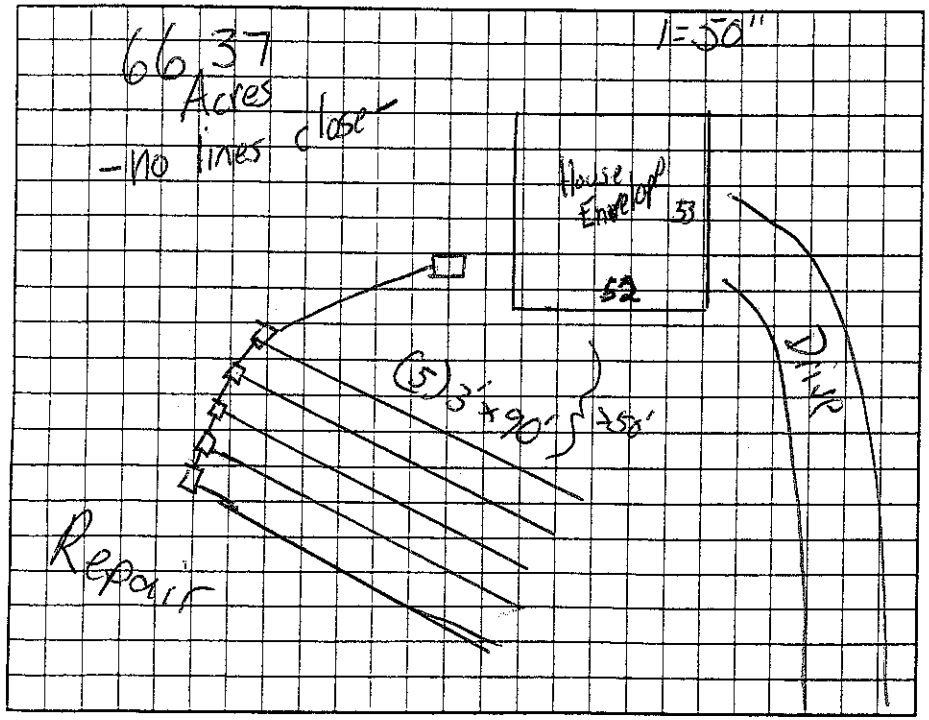

AS BUILT SKETCH

Permit can be suspended or revoked if any false information is supplied toward securing the permit/any unauthorized changes are made to the site/any unauthorized changes are made in the installation of the system. Improvement Permit with plat valid without expiration ☐ Improvement Permit with site plan valid for sixty months ☐ Authorization to Construct is valid for a period equal to that of Improvement Permit – not to exceed sixty months.

Signed: Wilson D Ellis date 10/24/06 Installed by: Dennis Hoyle

Improvement Permit by: _____ date 10/12/6 Operation Permit by: _____ date 5/23/08

Authorization to Construct by: _____ date 10/12/6 Existing System Inspection by: _____ date _____

HEALTH DEPT. COPY: WHITE OWNER COPY (FINAL): YELLOW OWNER COPY (INITIAL): PINK