IREDELL COUNTY HEALTH DEPARTMENT

STATESVILLE 704-878-5305 MOORESVILLE 704-664-5281

IMPROVEMENT PERMIT / AUTHORIZATION TO CONSTRUCT / OPERATION PERMIT / EXISTING SYSTEM INSPECTION

PERMIT# 86141 PIN# 4717 61 1198 DATE Nov 16 99

OWNER OR CONTRACTOR Tim Donnelly PHONE: Business _____ Home 876 2888

ADDRESS 869 Midway Rd STATESVille

LOCATION 116 N (T) Midway Rd PAST CoveGap Rd Property off Road on Left of Midway Rd Mailbox 869

SUBDIVISION _____ BLOCK / SECTION _____ LOT _____ LOT AREA 2Ac SITE CLASS. PS DESIGN FLOW 360 L.T.A.R. .3

Septic Tank: 1000 Gallons; STB 1012 Date 2-6-2000
Pump Tank: _____ Gallons; PT _____ Date _____
Pump Make: _____ Model _____ Serial No _____
Nitrification Field: No Fields 1 Square Feet 1200 Linear Feet 400
No Lines 4@100 Trench Width 36 Max Trench Bottom Depth 36" Gravel Depth 12"

☑ New System ☐ Repair System Type: I. (II.) III. IV. V. VI
System Description: Conv GRAVITY
Repair System Description: SAme
Maintenance Agreement Required: ☐ Yes ☒ No
☐ Slab ☐ Crawl Space ☒ Basement w/plumbing ☐ Basement wo/plumbing


☑ House/Mod. Home ☐ Mobile Home ☐ Business ☐ Other
No. Bedrooms 3 No. Bathrooms 2 No. Employees ____

Water Supply: ☑ Individual ☐ Public ☐ Community WELL

Comments/Conditions: INSTALL on CONTOUR
Keep well 100Ft From Septic System
CUT FOR BASEMENT Should not INTERFER WITH Septic Field
Questions CALL 928-2030

Comments/Conditions SEPTIC TANK W/ RISERS AND MARKER INSTALLED USING "Poly Lok" FILTER

INITIAL SITE SKETCH Not To Scale

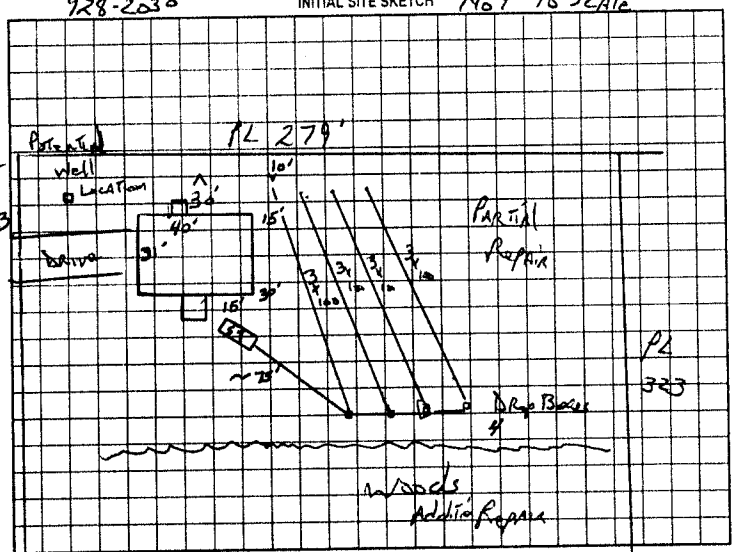

AS BUILT SKETCH

SYSTEM INSTALLED ACCORDING TO INITAL SITE SKETCH

Permit can be suspended or revoked if any false information is supplied toward securing the permit/any unauthorized changes are made to the site/any unauthorized changes are made in the installation of the system. Improvement Permit with plat valid without expiration. Improvement Permit with site plan valid for sixty months. Authorization to Construct is valid for a period equal to that of Improvement Permit – not to exceed sixty months.

Signed: Tim Donnelly 11/18/99 date _____

Improvement Permit by: L Potter date Nov 16 99

Authorization to Construct by: L Potter date Nov 16 99

Installed by: BRENT GALLIHER

Operation Permit by: STEVE HEDRICK date 6-7-2000

Existing System Inspection by: _____ date _____

HEALTH DEPT COPY WHITE OWNER COPY (FINAL) YELLOW OWNER COPY (INITIAL) PINK