IREDELL COUNTY HEALTH DEPARTMENT

STATESVILLE 704-878-5305 MOORESVILLE 704-664-5281

IMPROVEMENT PERMIT / AUTHORIZATION TO CONSTRUCT / OPERATION PERMIT / EXISTING SYSTEM INSPECTION

PERMIT# 078437 PIN# 4717 53 8311 DATE 12-31-98

OWNER OR CONTRACTOR HUNTING CREEK BUILDING CO. PHONE: Business 539-5539 Home

ADDRESS 1000 UNION GROVE ROAD, UNION GROVE NC 28689

LOCATION NC 115 N, TL MIDWAY ROAD, 2ND LOT ON LEFT PAST DUKE POWER HIGH TENSION POWER LINES (AT COVE GAP ROAD)

SUBDIVISION MTN. VIEW EST BLOCK / SECTION LOT 52 LOT AREA 1.32 ACRES SITE CLASS. P3 DESIGN FLOW 360 L.T.A.R. 0.30 GPD/FT²

Septic Tank: 1000 Gallons; STB 1012 Date 1-14-99
Pump Tank: Gallons; PT Date
Pump Make: Model Serial No.
Nitrification Field: No Fields 1 Square Feet 1200 Linear Feet 400
No Lines FOUR Trench Width 36" Max Trench Bottom Depth 36" Gravel Depth 12"

[X] New System [ ] Repair System Type: I, II, III, IV, V, VI
System Description: CONVENTIONAL GRAVITY
Repair System Description: CONV. GRAVITY
Maintenance Agreement Required: [ ] Yes [X] No
[ ] Slab [X] Crawl Space [ ] Basement w/plumbing [ ] Basement wo/plumbing


[X] House/Mod. Home No. Bedrooms 3
[ ] Mobile Home No. Bathrooms 2
[ ] Business No. Employees
[ ] Other

Water Supply: [X] Individual [ ] Public [ ] Community
WELL


Comments:/Conditions: KEEP SYSTEM MINIMUM 100 FEET FROM WELL

Comments:/Conditions: ① SYSTEM ALTERED AS SHOWN BELOW WITHOUT PRIOR APPROVAL FROM HEALTH DEPT. ② SEPTIC TANK WITH RISERS INSTALLED WITH "POLYLOK" FILTER.

INITIAL SITE SKETCH SCALE: 1"=50'

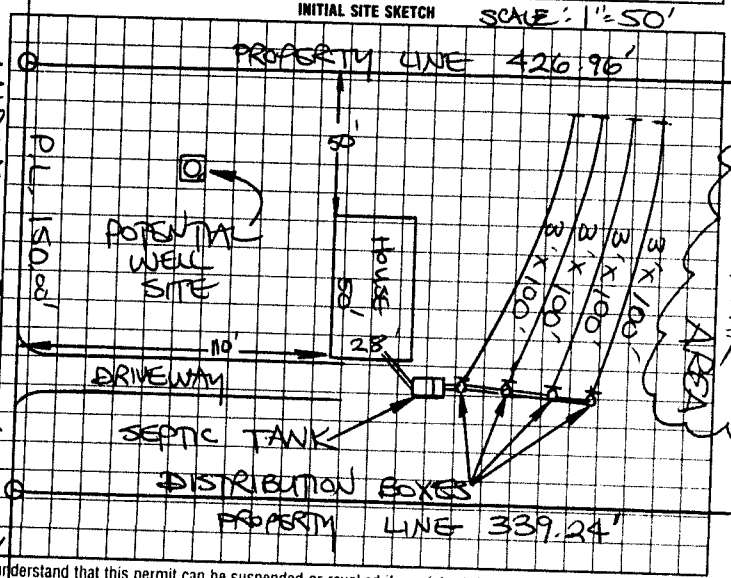

AS BUILT SKETCH

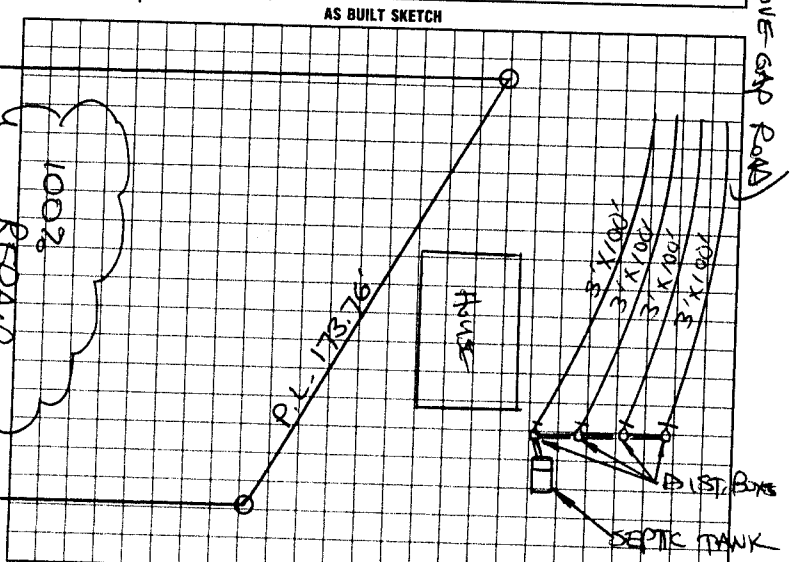

I understand that this permit can be suspended or revoked if any false information is supplied toward securing the permit/any unauthorized changes are made to the site/any unauthorized changes are made in the installation of the system. Improvement Permit with plat valid without expiration. Improvement Permit with site plan valid for sixty months. Authorization to Construct is valid for a period equal to that of Improvement Permit – not to exceed sixty months.

Signed: Deana Kranz date 1-5-99 Installed by: TOMMY FRYE

Improvement Permit by: STEVE HEDRICK date 12-31-98 Operation Permit by: STEVE HEDRICK date 3-31-99

Authorization to Construct by: STEVE HEDRICK date 12-31-98 Existing System Inspection by: date

HEALTH DEPT. COPY: WHITE INSPECTION COPY (FINAL) GREEN OWNER COPY (FINAL) YELLOW INSPECTION COPY (INITIAL) PINK OWNER COPY (INITIAL) GOLD