IREDELL COUNTY HEALTH DEPARTMENT

STATESVILLE 704-878-5305 MOORESVILLE 704-664-5281

IMPROVEMENT PERMIT / AUTHORIZATION TO CONSTRUCT / OPERATION PERMIT / EXISTING SYSTEM INSPECTION

PERMIT# 093915 PIN# 4717549175 DATE 01-24-01

OWNER OR CONTRACTOR BILL GLAVEN JR Calvin Gill, Agt. PHONE: Business _____ Home 704-622-2725

ADDRESS 96 MAPLE ST, [redacted] JERSEY CITY, NJ 07304

LOCATION 115 N, L MIDWAY, @ 2 MILES ON right post 2nd COVE GAP RD

SUBDIVISION MTN VIEW ESTATES BLOCK / SECTION _____ LOT 6 LOT AREA 2.32 ACRES SITE CLASS PS DESIGN FLOW 480 L.T.A.R. .3

Septic Tank: 1000 Gallons; STB 1012 Date 3-13-01
Pump Tank: _____ Gallons; PT _____ Date _____
Pump Make: _____ Model _____ Serial No _____
Nitrification Field: No Fields 1 Square Feet 1600 Linear Feet 533'
No Lines 4 Trench Width 36" Max Trench Bottom Depth 36" Gravel Depth _____

X New System ☐ Repair System Type: I (II) III IV V VI
System Description: CONV GRAVITY
Repair System Description: CONV GRAVITY
Maintenance Agreement Required: ☐ Yes X No

X House (Mod) Home No. Bedrooms 4
☐ Mobile Home No. Bathrooms 2
☐ Business No. Employees _____
☐ Other _____


☐ Slab X Crawl Space ☐ Basement w/plumbing ☐ Basement wo/plumbing

Water Supply:
X Individual
☐ Public
☐ Community
WELL


Comments/Conditions: ① Keep well 100' From SYSTEM ② Install lines on contour ③ Keep system 5' off house & 10' off property lines ④ USE 4 DROP BOXES

Comments/Conditions: 4-12-01 = (LL) LINES & LENGTHS CHANGED DUE TO POWER LINE ROW ENCROACHMENT WITH MY APPROVAL. - Poly lok Filter Installed - Septic Tank Marker Installed

INITIAL SITE SKETCH NOT TO SCALE

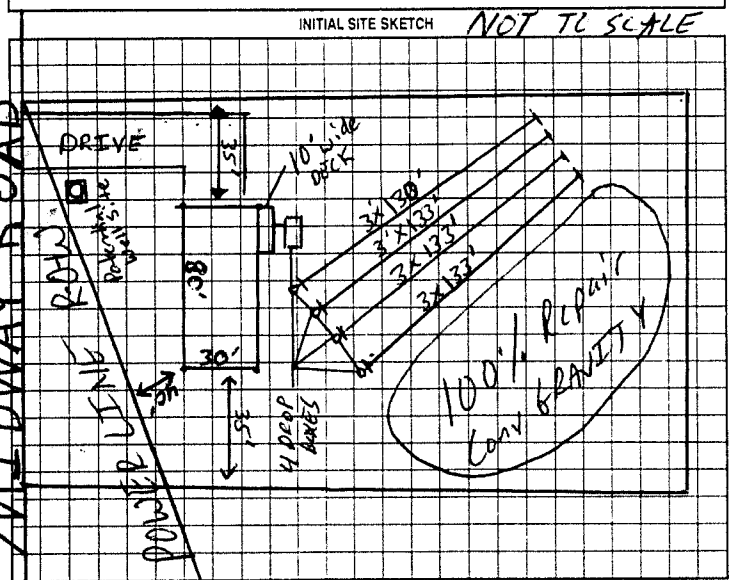

AS BUILT SKETCH not to scale

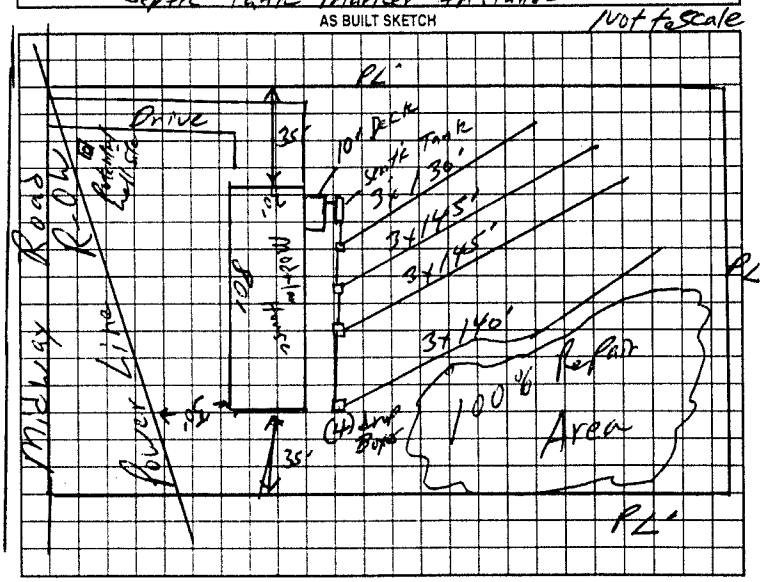

Permit can be suspended or revoked if any false information is supplied toward securing the permit/any unauthorized changes are made to the site/any unauthorized changes are made in the installation of the system. Improvement Permit with plat valid without expiration. Improvement Permit with site plan valid for sixty months. Authorization to Construct is valid for a period equal to that of Improvement Permit – not to exceed sixty months.

Signed: _____ date 2-28-01 Installed by: [redacted] A1 Backhoe

Improvement Permit by: Jane Cook RST date 01-26-01 Operation Permit by: William O. Johnson RSS date 4-17-01

Authorization to Construct by: Jane Cook RST date 01-26-01 Existing System Inspection by: _____ date _____

HEALTH DEPT. COPY WHITE OWNER COPY (FINAL) YELLOW OWNER COPY (INITIAL) PINK